
2205

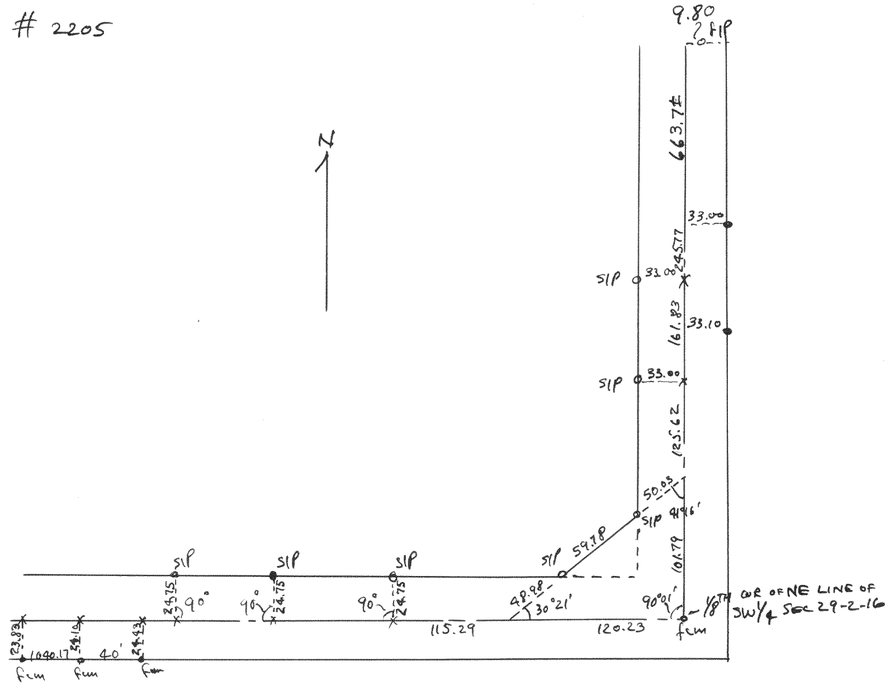


Plat of survey of road line on Little property located in SW¼ of Sec 29, T2N R16E of Walworth Co Wisconsin.

May 15, 1950

Lloyd J. Jensen
County Surveyor

2206

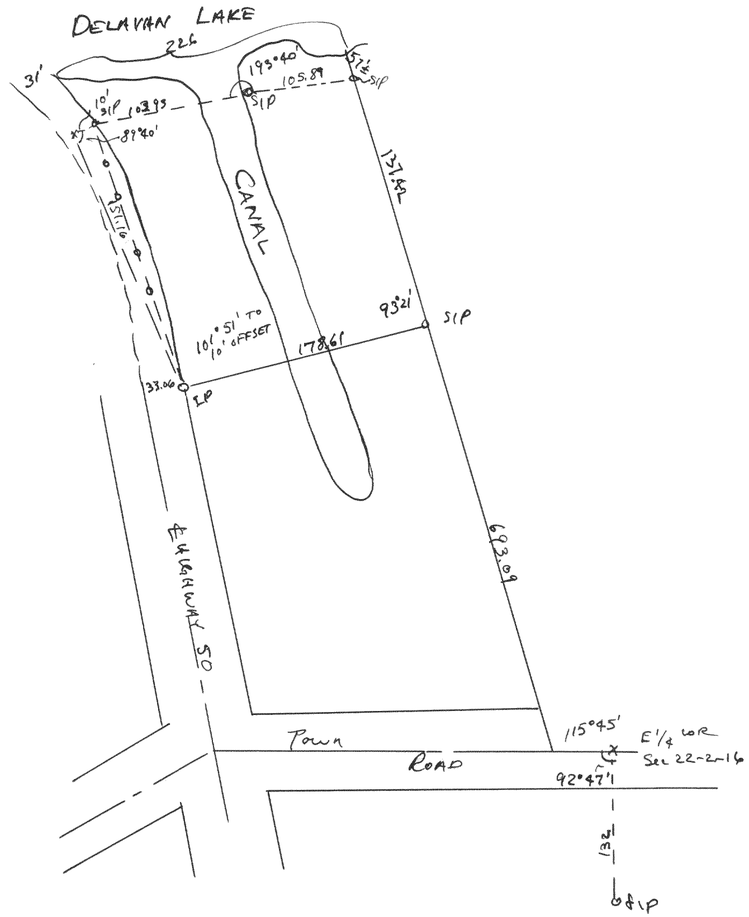

Plat of survey of a parcel of land on Humphrey property located in NE¼ of Sec 22, T2N R16E of Walworth Co, Wis.

May 22, 1950

Lloyd J. Jensen
County Surveyor