

2209

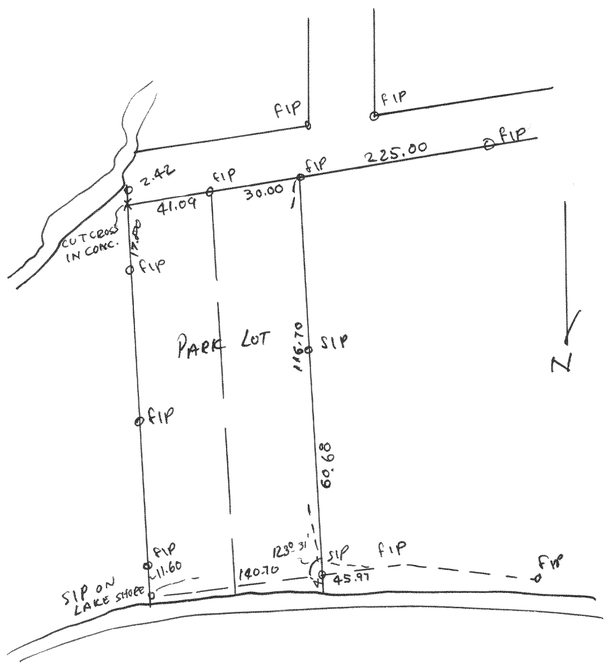

Plat of survey of the Community Park South shore
M/sand located in Sec 32, T2N R16E of Walworth County, Wis.
Aug. 4, 1950
Floyd L. Jensen
County Surveyor

2210

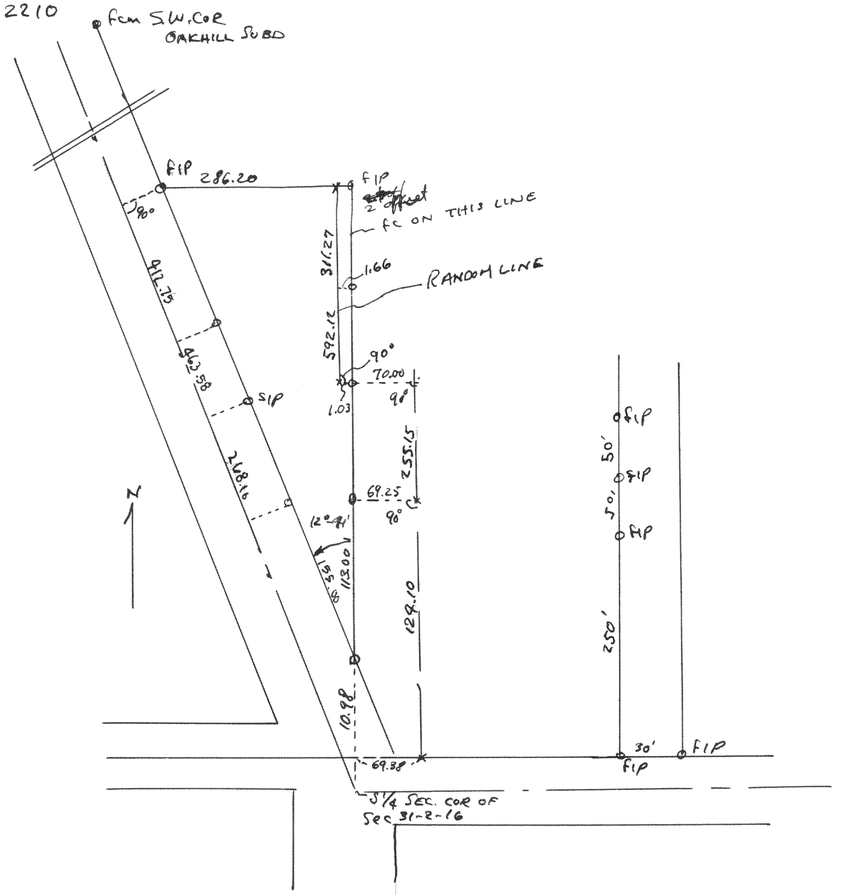

Plat of survey of Krueger property located in the SW¼ of Sec 31, T2N R16E, of Walworth County, Wis.
Aug 8, 1950
Floyd L. Jensen
County Surveyor