
496


#2211

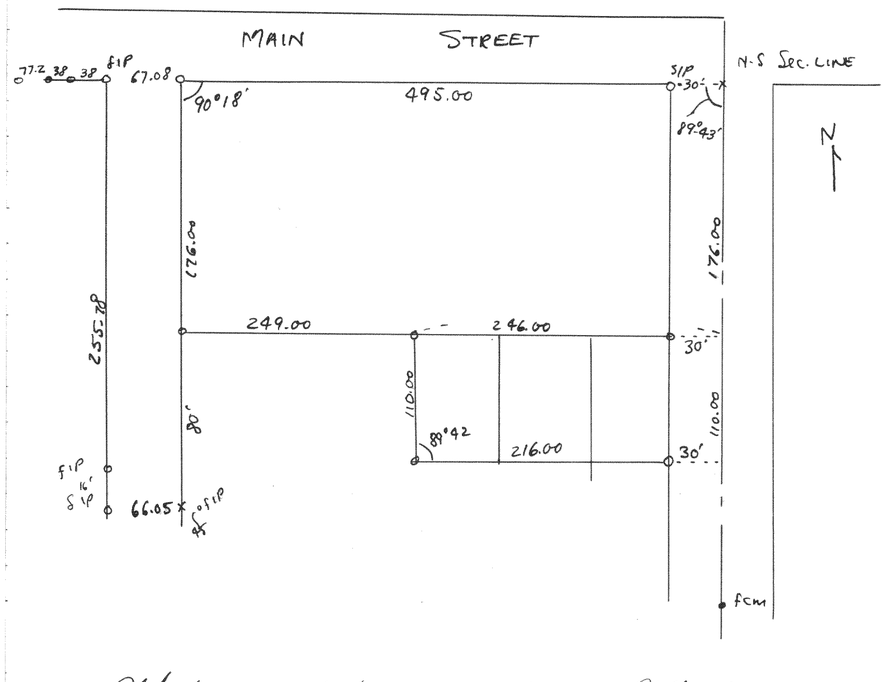

Plat of survey of Catholic Church located in Phillips Subd. in the City of Lake Geneva, Walworth Cty, Wis.
1950

Lloyd S. Jensen
County Surveyor

#2212

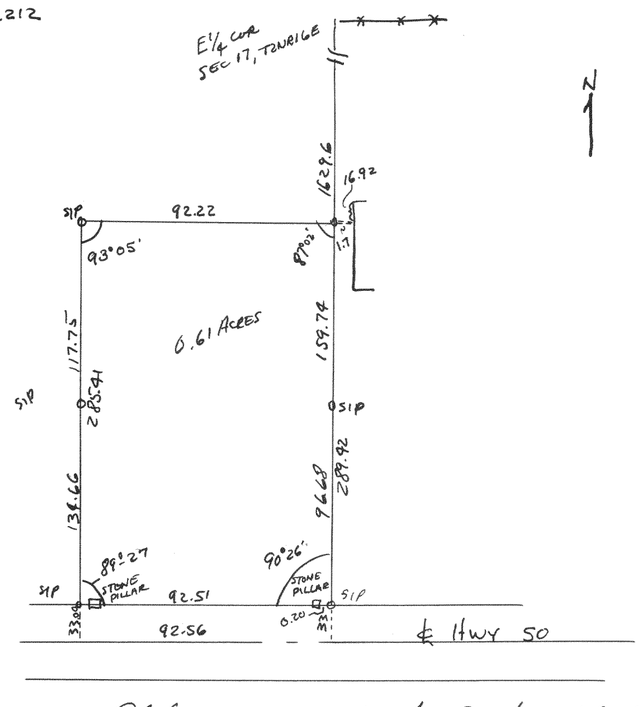

Plat of survey of the Homer Smith Estate located in the SE1/4 of Sec 17, T2NR16E of Walworth Co., Wis.
Aug 31, 1950

Lloyd S. Jensen
County Surveyor