

#2213

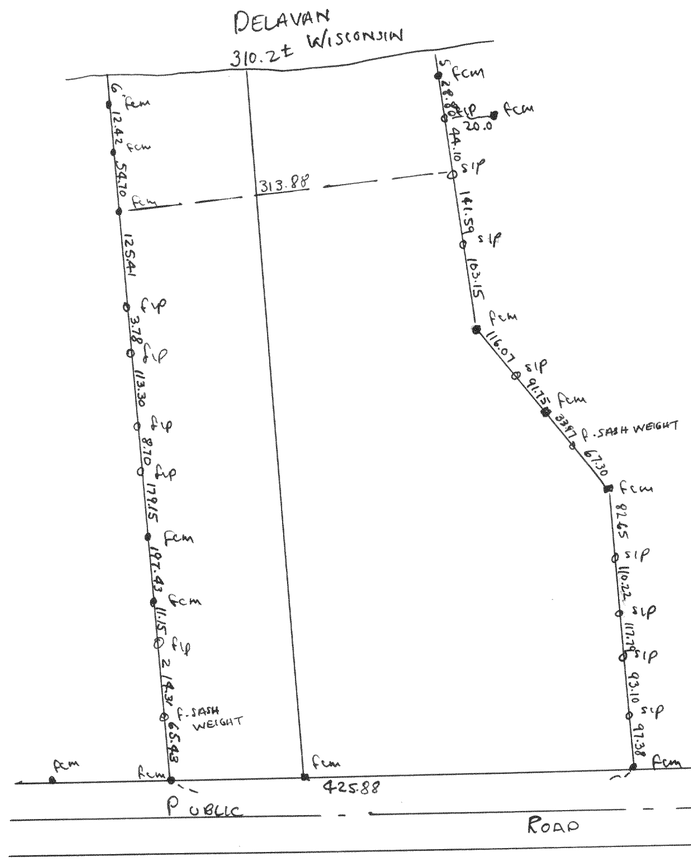

Plat of survey of a part of the W.R. Abbott Estate, being part of Abbott & Robbins Subdivision located in Section 28 & 33, T2N R16E of Walworth County, Wisconsin
Sept. 18, 1950

Lloyd L. Jensen
County Surveyor

#2214

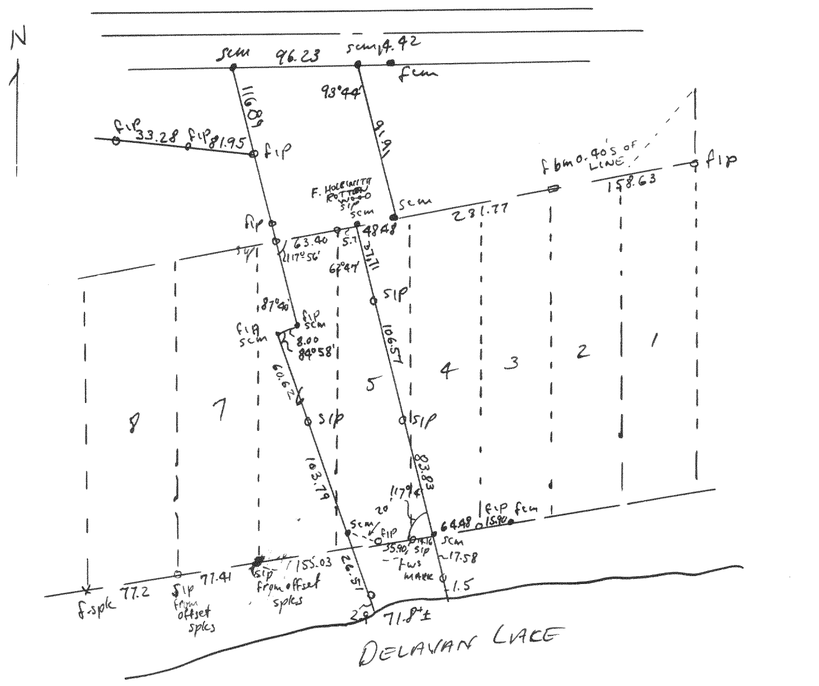

Plat of survey of parts of Lots 4, 5, & 6 of Sidon Subdivision located in Sec 28, T2N R16E
Oct 3, 1950

Lloyd L. Jensen
County Surveyor