

2216 A

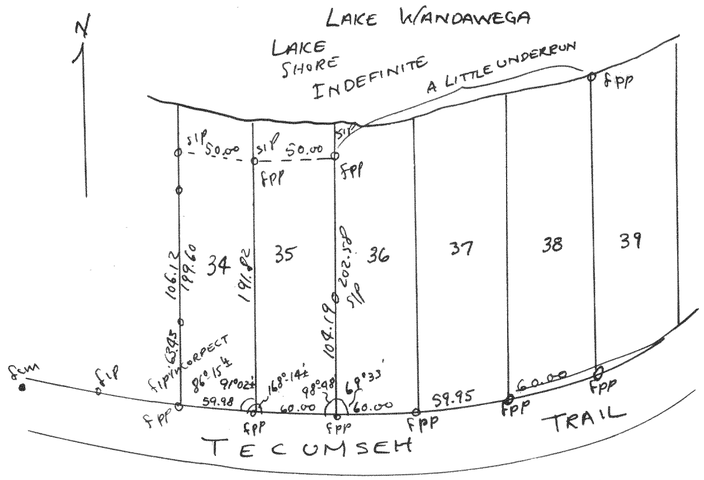

Survey of Lots 34 & 35 of Wandawega Highlands, Block I located in Section 11 & 12, T3N R16E, Walworth Co., Wis.
May 20, 1950


2217

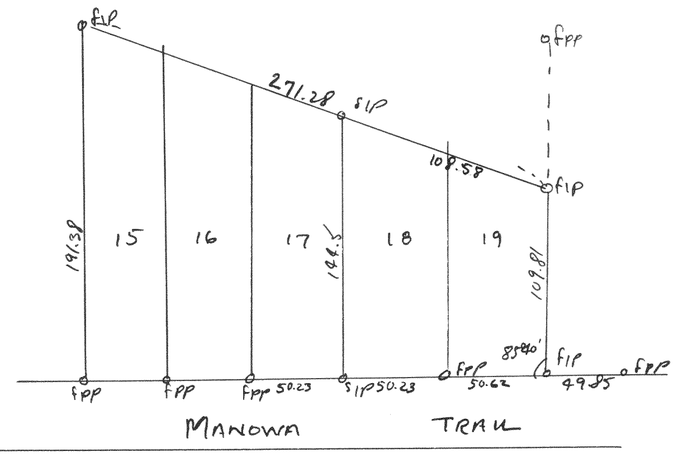

Plat of survey of Lots 18 & 19 Block 4 of Wandawega Highlands located in Sections 11 & 12, T3N R16E of Walworth Co., Wis.
May 20, 1950

Floyd L. Jensen
County Surveyor

2218

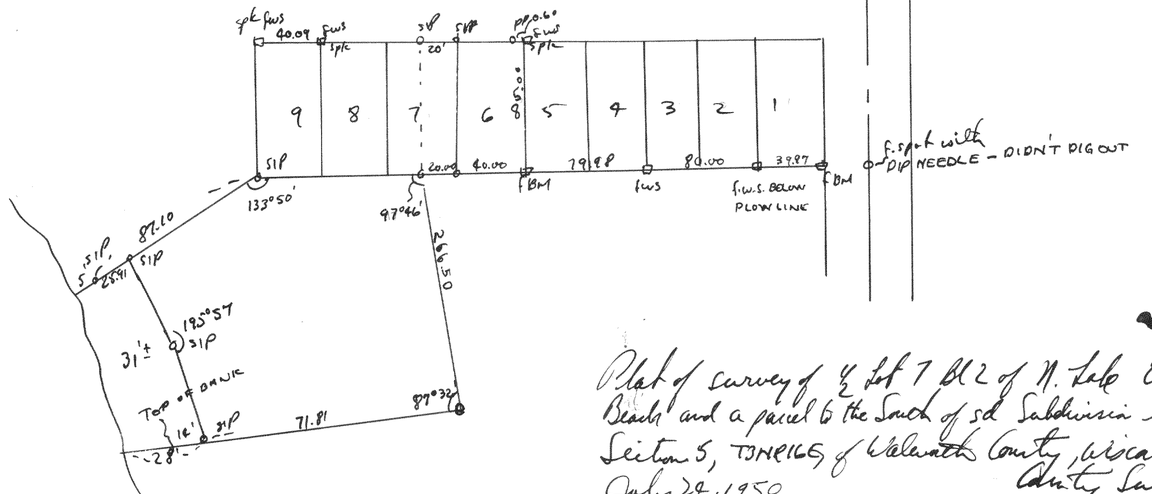

Plat of survey of ½ Lot 7 Bl 2 of N. Lake Evergreen Beach and a parcel to the South of sd Subdivision located in Section 5, T3N R16E of Walworth County, Wisconsin
July 24, 1950

County Surveyor
Floyd L. Jensen