

SURVEY NO. 1193

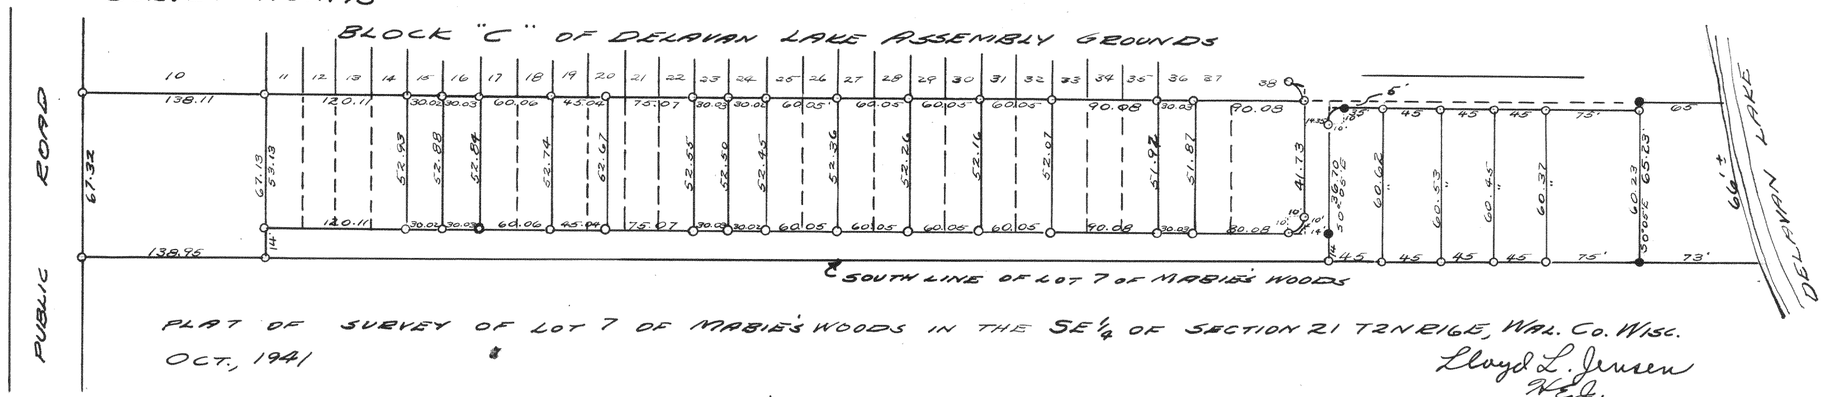

PLAT OF SURVEY OF LOT 7 OF MABIE'S WOODS IN THE SE¼ OF SECTION 21 T2N R16E, WAL. CO. WISC.
OCT., 1941

Lloyd L. Jensen
R.E.J.


SURVEY NO. 1194

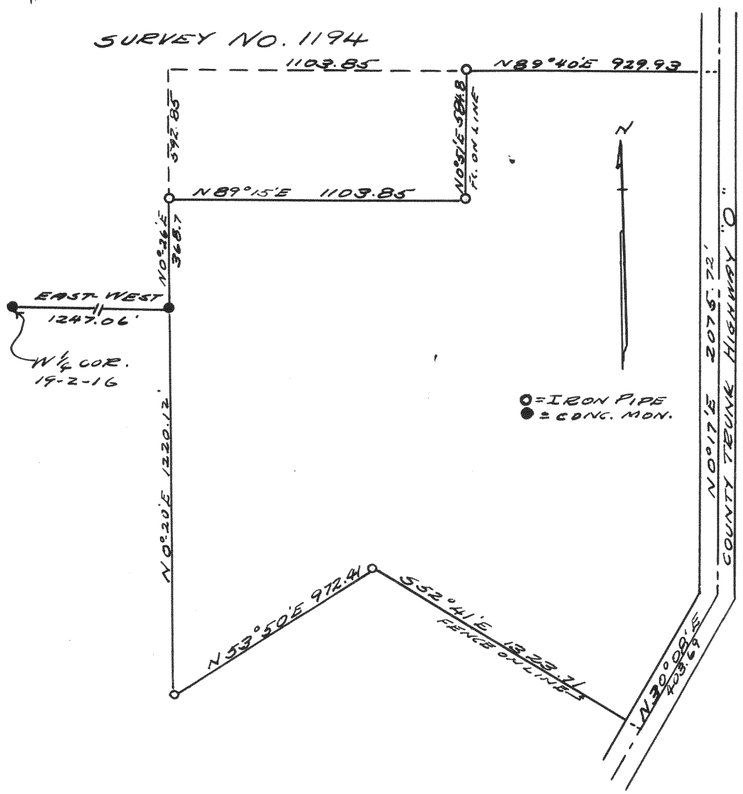

PLAT OF SURVEY OF LAND IN THE E½ + W½ OF SECTION 19 T2N R16E, WAL. CO. WISC.
DEC. 9, 1941

Lloyd L. Jensen
R.E.J.

SURVEY NO. 1195

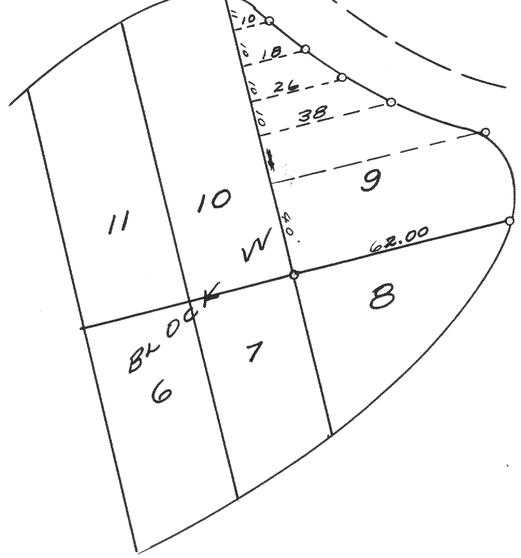

PLAT OF SURVEY OF LOT 9 BLOCK "W" OF DELAVAN LAKE ASSEMBLY GROUNDS, WALWORTH COUNTY, WISCONSIN.
OCT. 1941

Lloyd L. Jensen
R.E.J.