
#2221

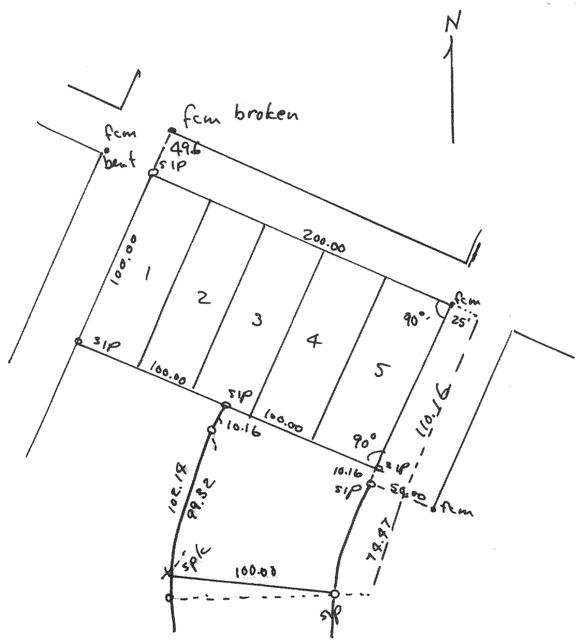


Plat of survey of Lots 1,2,3,4,5 & 30, Block 39 of Interlaken located in Sec 11, T3NR16E of Walworth County Wis.

Sept 25, 1950

Lloyd L. Jensen
County Surveyor

#2222

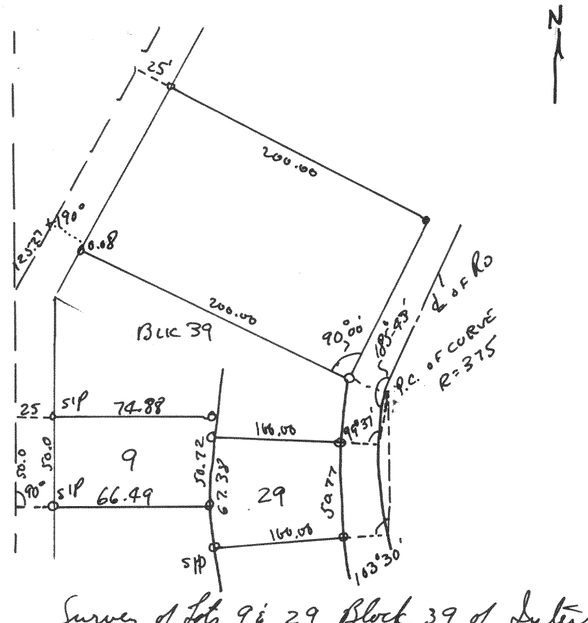


Survey of Lots 9 & 29 Block 39 of Interlaken located in Sec 11, T3NR16E of Walworth County, Wis.

October 9, 1950

Lloyd L. Jensen
County Surveyor

#2223

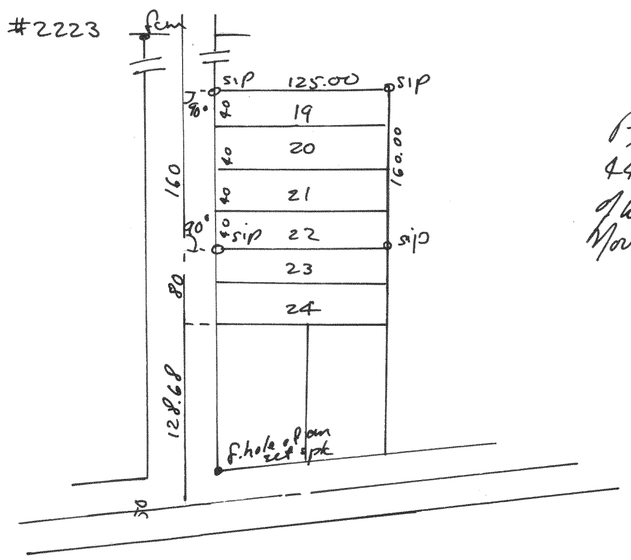

Plat of survey of Lots 19-22 incl, Block 44 Interlaken located in Sec 11, T3NR16E of Walworth County, Wis

Nov 10, 1950

Lloyd L. Jensen
County Surveyor