

#2226

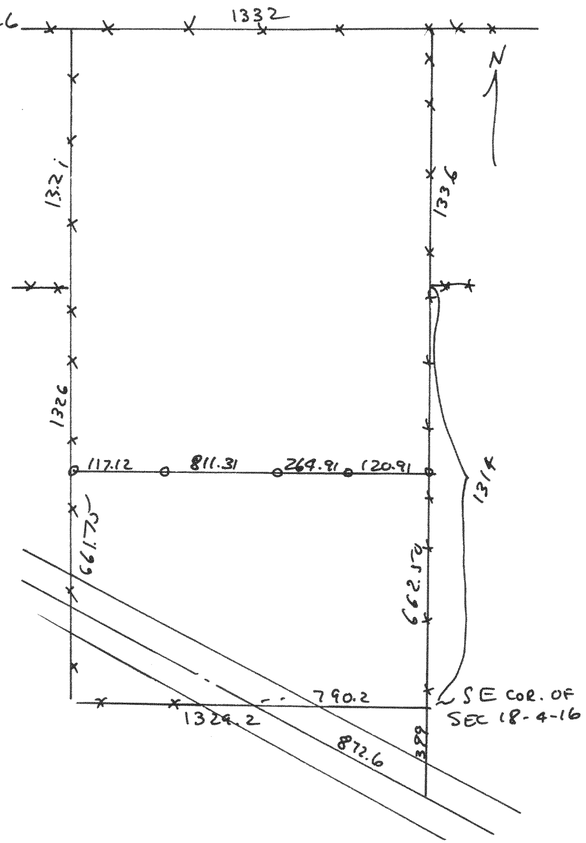


Survey of the S¼ of 80 acres in the E½ of the SE¼ of Sec 18, T4N R16E of Walworth County, Wis.
June 28, 1950
Lloyd F. Jensen
County Surveyor

#2227

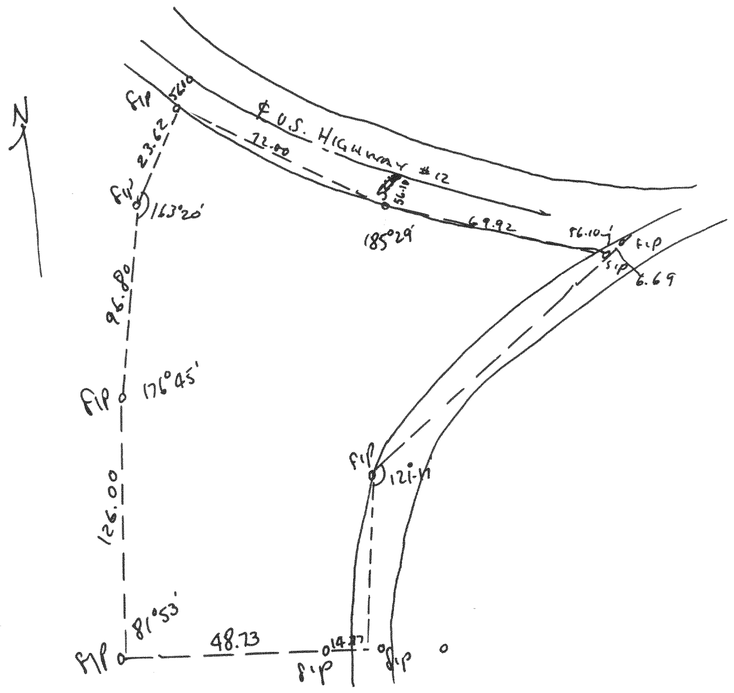


Plat of survey of a parcel of land located in the W ½ of Section 36, T4N R16E, of Walworth County, Wis.
1950
Lloyd F. Jensen
County Surveyor