

506

#2232

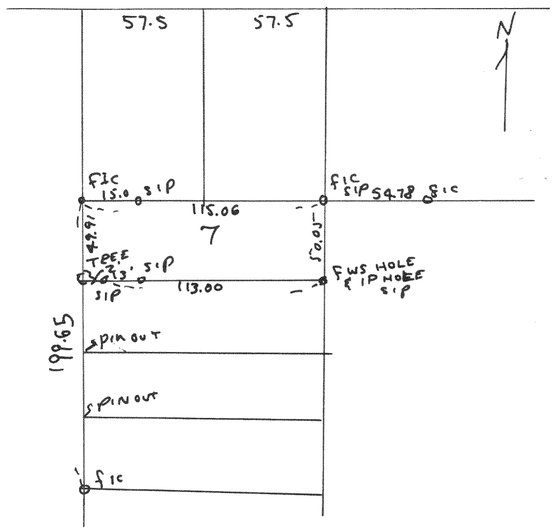


Plat of survey of Lot 7 Bl 25, of Sunset Hills Subd located in the SW¼ of Section 33, T2NR17E of Walworth County, Wis.
April 9, 1950
Floyd L. Jensen
County Surveyor

#2233

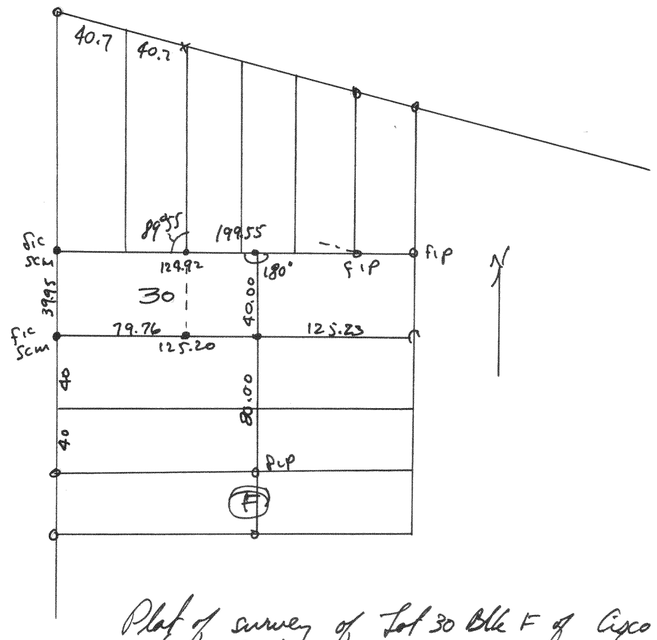


Plat of survey of Lot 30 Blk F of Cisco Beach located in Section 19 T1NR17E of Walworth Cty, Wis.
July 1950
Floyd L. Jensen
County Surveyor

#2234

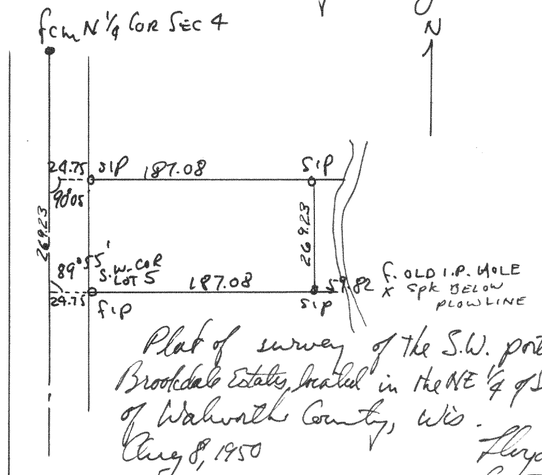

Plat of survey of the S.W. portion of Lot 5 Brookdale Estate, located in the NE¼ of Sec 4, T1NR17E of Walworth County, Wis.
Aug 8, 1950
Floyd L. Jensen
County Surveyor

#2235

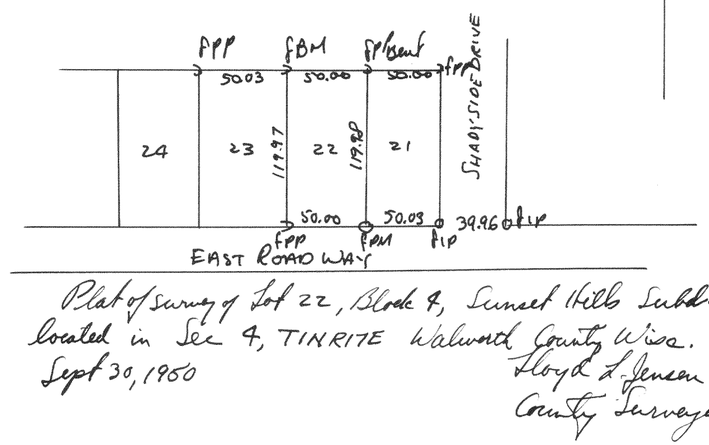

Plat of survey of Lot 22, Block 4, Sunset Hills Subd. located in Sec 4, T1NR17E Walworth County Wisc.
Sept 30, 1950
Floyd L. Jensen
County Surveyor