
508


#2238

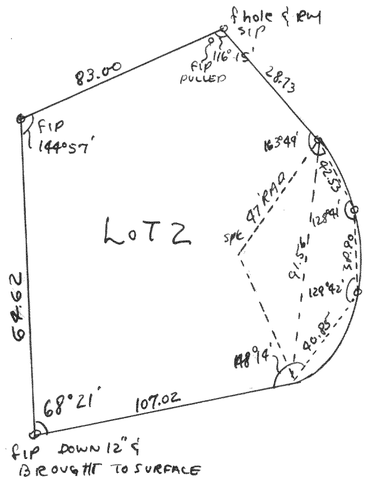

Plat of survey of Lot 2, Blk 1 of Woodlake Add., located in the SW¼ of Sec 9, T1N R17E Walworth Co., Wis.
June 5, 1950

Floyd L. Jensen
County Surveyor

#2239

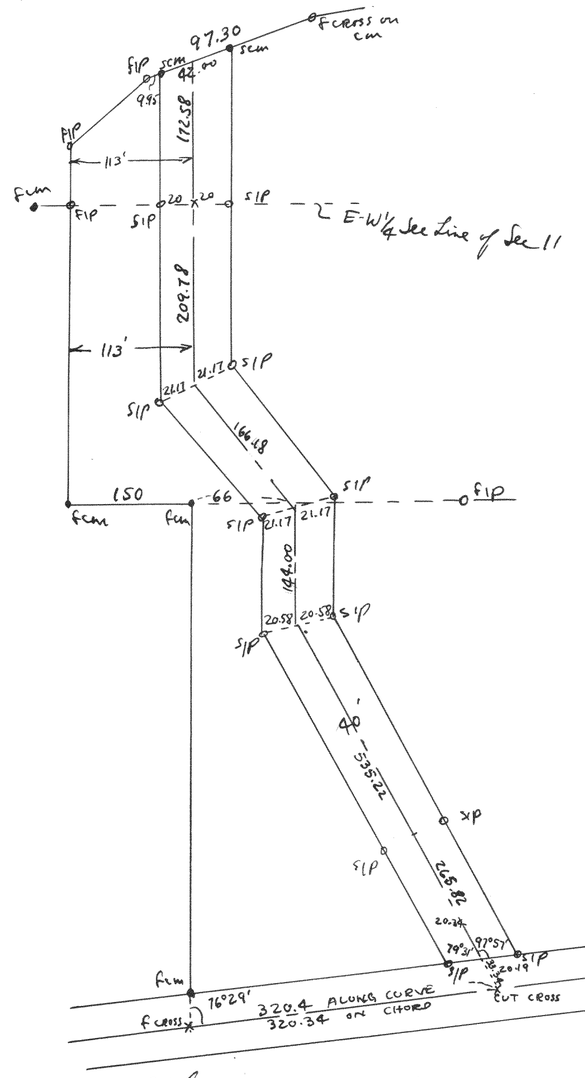

Plat of proposed road & division of Jacobs Property purchased from the Hyatt Estates located in Sec 11, T1N R17E of Walworth Co., Wis.
Dec 28, 1949

Floyd L. Jensen
County Surveyor