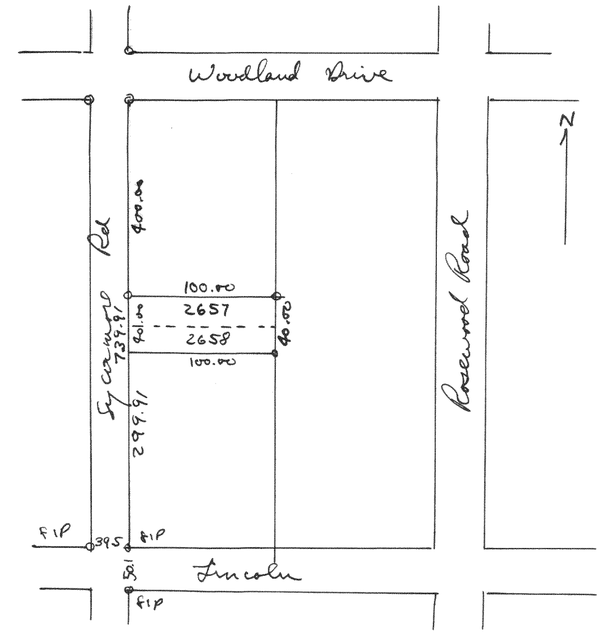
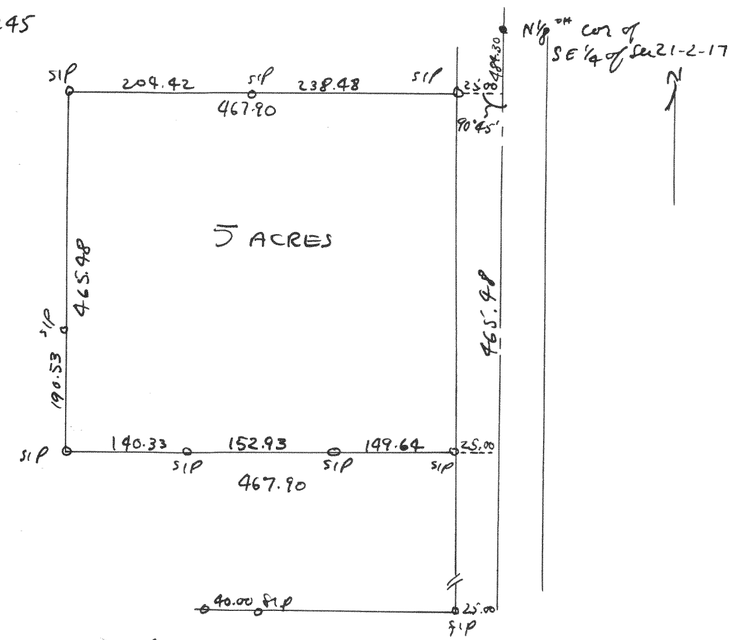
#2244



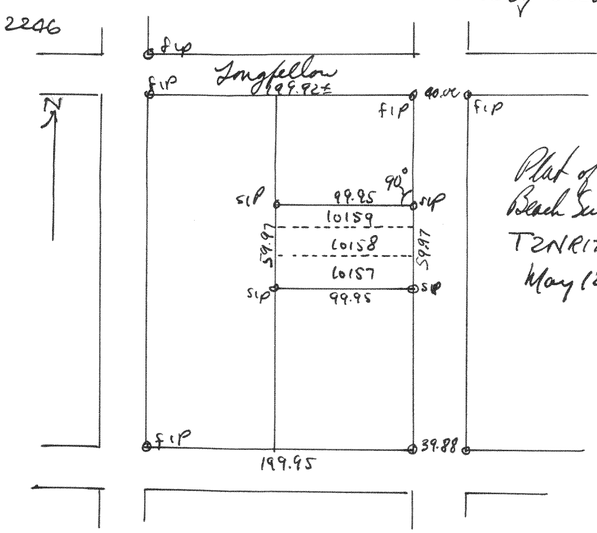

Plat of survey of Lots 2657-2658 of Lake Como Beach Subd located in Sec 21 & 22, T2NR17E of Walworth Cty, Wis.
May 1, 1950
Floyd L. Jensen
County Surveyor

#2245



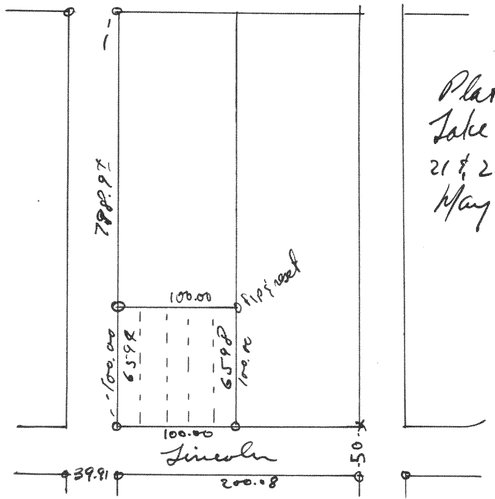

Plat of survey of the same parcel for Como School located in the SE¼ of Sec 21 T2NR17E of Walworth County, Wis.
May 10, 1950
Floyd L. Jensen
County Surveyor

#2246




Plat of survey of Lots 10158-10159 Lake Como Beach Subd located in Sec 21 & 22 T2NR17E of Walworth County, Wis.
May 12, 1950
Floyd L. Jensen
County Surveyor

#2247




Plat of Survey of Lots 6598-6594 of Lake Como Beach Subd located in Sec. 21 & 22, T2NR17E of Walworth County Wis.
May 31, 1950
Floyd L. Jensen
County Surveyor