

2251

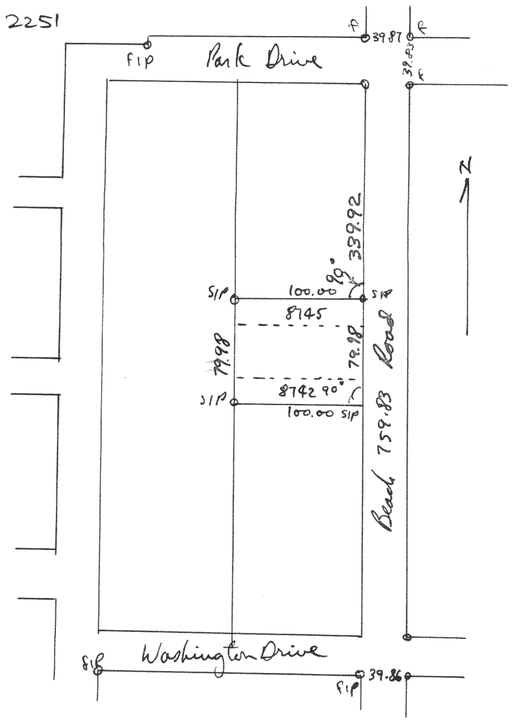

Plat of survey of lots 8742–8745 of Lake Como Beach Subd located in Sec 21 & 22 T2NR17E of Walworth County, Wisconsin
Aug 8, 1950

Floyd L. Jensen
County Surveyor

2252

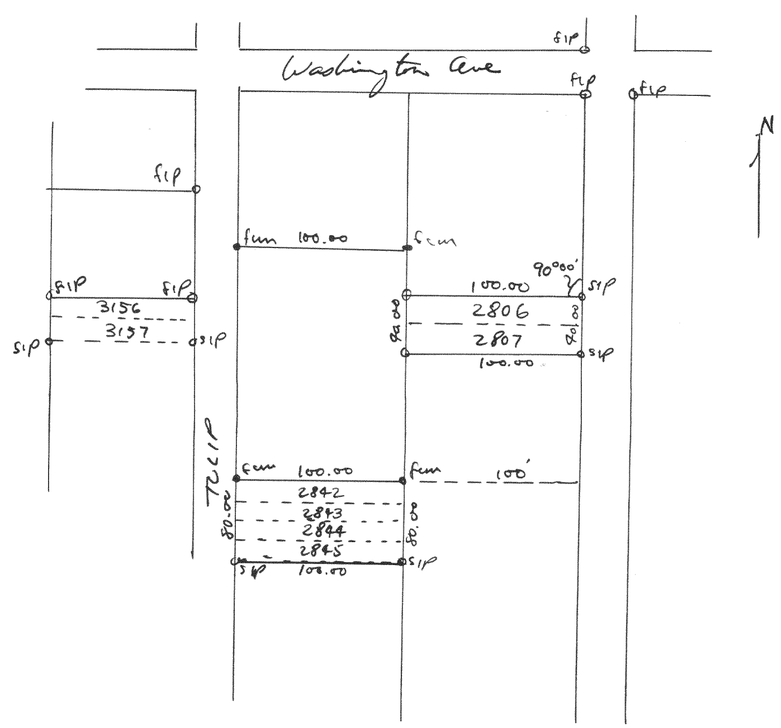

Plat of survey of lots 3156-7, 2842-5, 2806-7, Lake Como Beach Subd located in Sec 21 & 22, T2NR17E of Walworth County, Wis.
Aug 28, 1950

Floyd L. Jensen
County Surveyor