
514

#2253

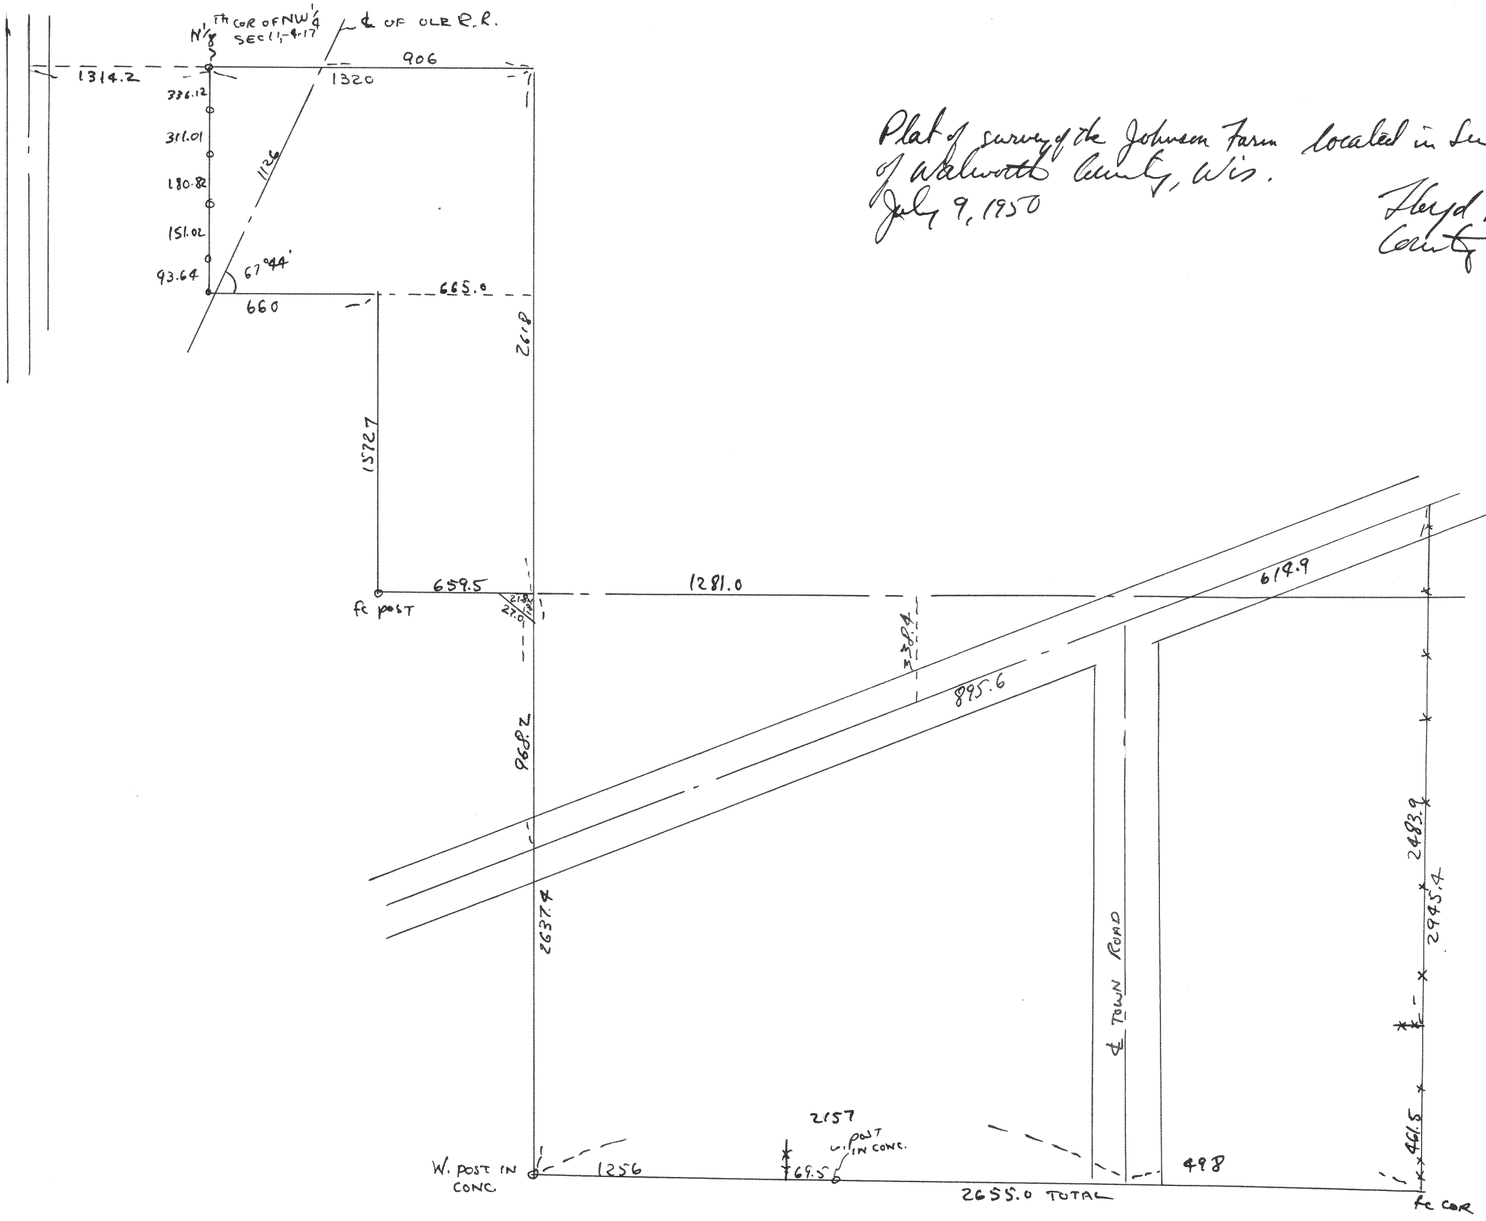

Plat of survey of the Johnsen Farm located in Sec 11, T4N R17E of Walworth County, Wis.
July 9, 1950

Floyd L. Jensen
County Surveyor