

#2256

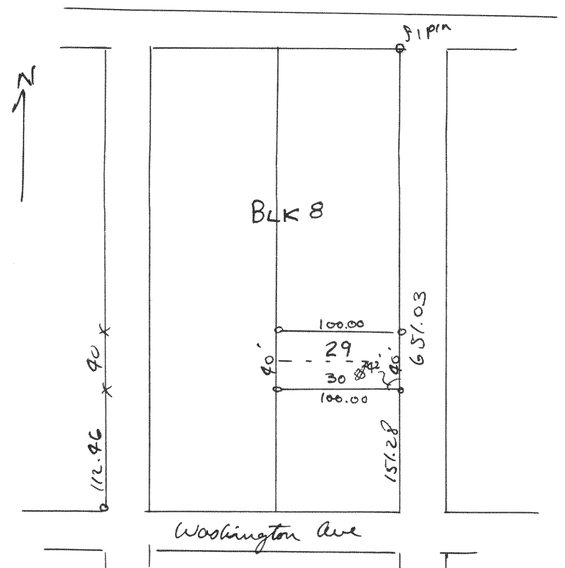


Plat of survey of Lots 29&30 Blk 8 of Lake Ivanhoe Resort located in Sec 2, T1NR18E of Walworth County, Wis.
July 1950
Lloyd S. Jensen
County Surveyor

#2257

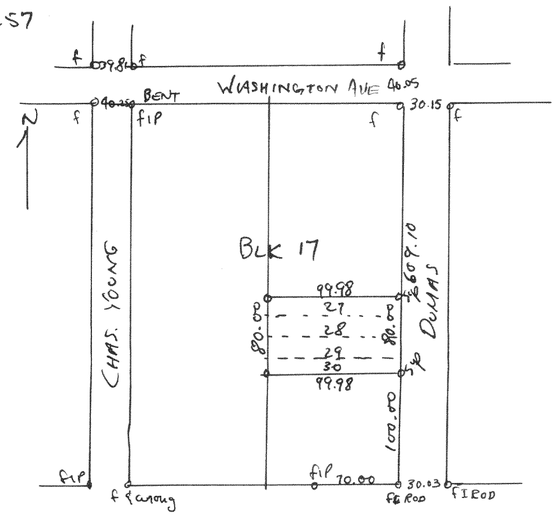


Plat of survey of Lots 27-30 Blk 17, of Lake Ivanhoe Resort located in Sec 2, T1NR18E of Walworth County, Wis.
Aug 2, 1950
Lloyd S. Jensen
County Surveyor

#2258

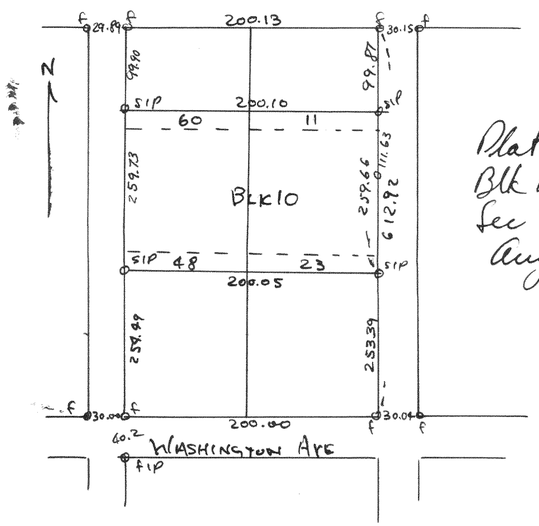

Plat of survey of Lots 11-23, 48-60 Blk 10, Lake Ivanhoe Resort located in Sec 2, T1NR18E, Walworth Cty, Wis.
Aug 2, 1950
Lloyd S. Jensen
County Surveyor

#2259

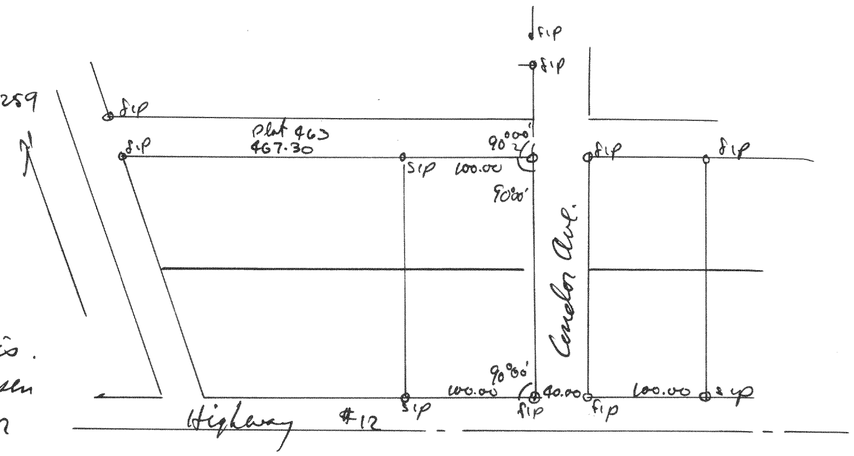

Plat of survey of Lots 8232-8251 Incl., of Bell Lake Subd located in Sec 22, T1NR18E, Walworth County, Wis.
Aug 17, 1950
Lloyd S. Jensen
County Surveyor