

#2266

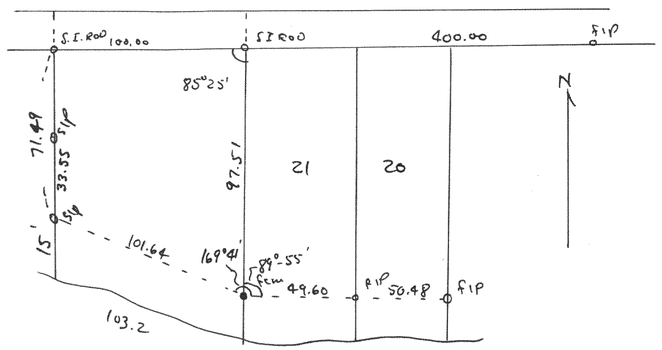

Plat of survey of a parcel of land owned by Stein & located at the west end of Trueks 2nd Subd in Sec 18, T4NR18E of Walworth County, Wis.
May 5, 1950

Lloyd F. Jensen
County Surveyor


#2267

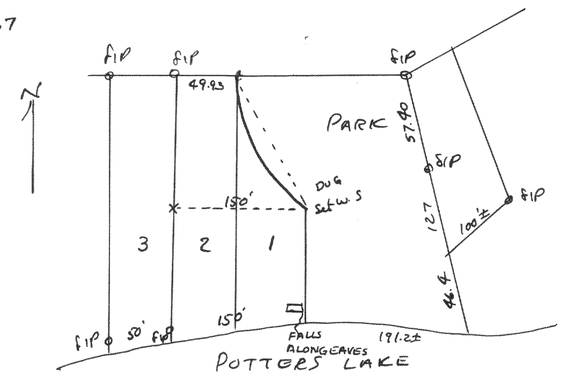

Partial Survey of the Private Park Area located in Miramar Subd in Sections 10 & 11, T4NR18E, Walworth County, Wis.
May 19, 1950

Lloyd F. Jensen
County Surveyor


#2268

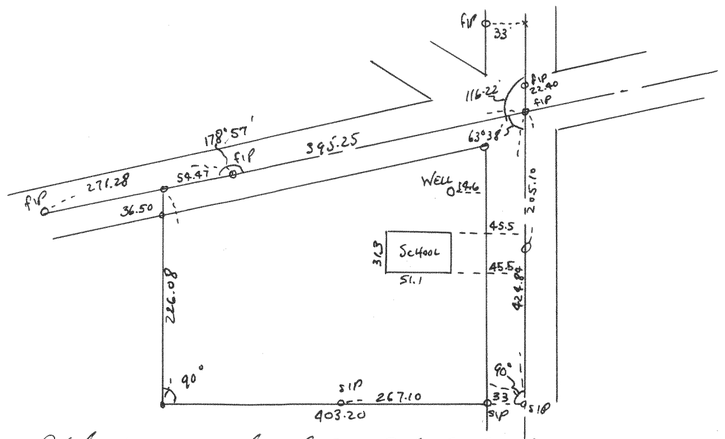

Plat of survey of deeded Stone School located in SE ¼ of SE ¼ of Sec 11, T4NR18E of Walworth Co., Wis.
Aug 14, 1950

Lloyd F. Jensen
County Surveyor

#2269

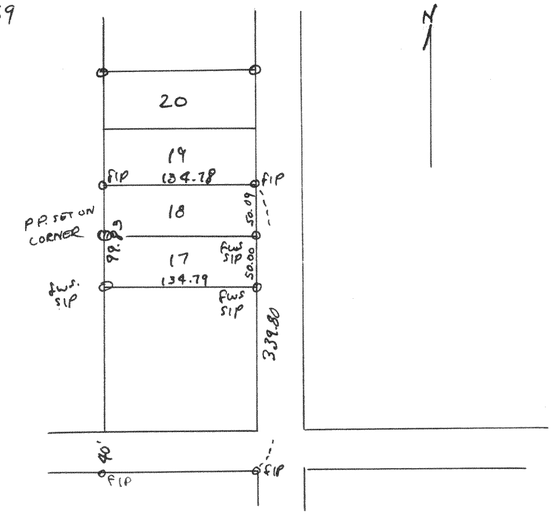

Plat of Survey of Lot 17, Blk 13, Miramar Subd in Sections 10 & 11, T4NR18E, Walworth County, Wisconsin
Sept 12, 1950

Lloyd F. Jensen
County Surveyor