

SURVEY NO. 1277

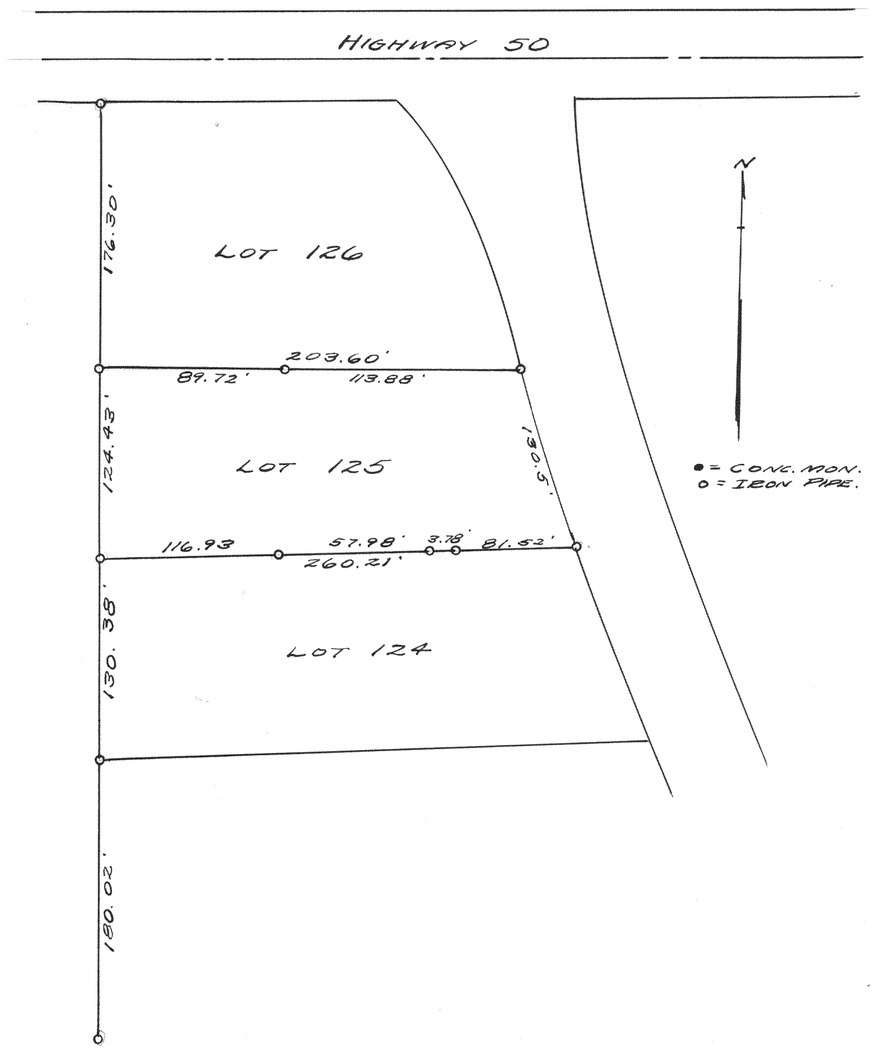

PLAT OF SURVEY OF LOT 125 OF GRAND TERRACE SUBDIVISION IN THE VILLAGE OF WILLIAMS BAY, WALWORTH COUNTY, WISC.
JAN. 14, 1942

Lloyd L. Jensen
R.E.J.

SURVEY NO. 1278

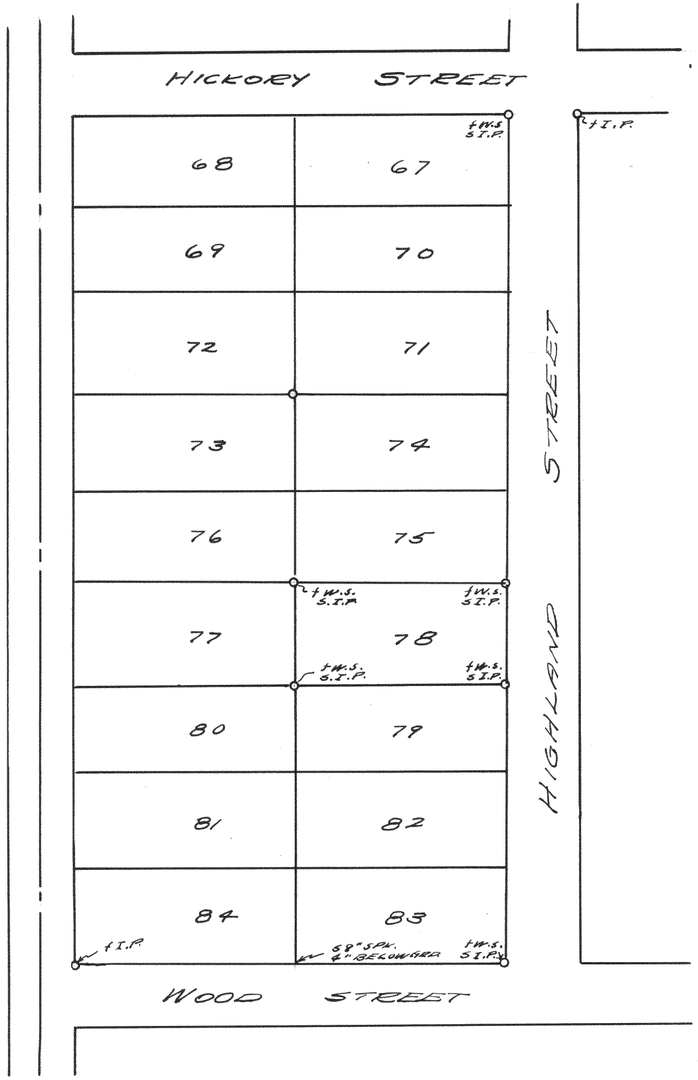

PLAT OF SURVEY OF LOT 78 OF BAY VIEW SUBDIVISION, IN THE VILLAGE OF WILLIAMS BAY, WALWORTH CO., WISC.
JULY, 1941

Lloyd L. Jensen
R.E.J.