

#2270

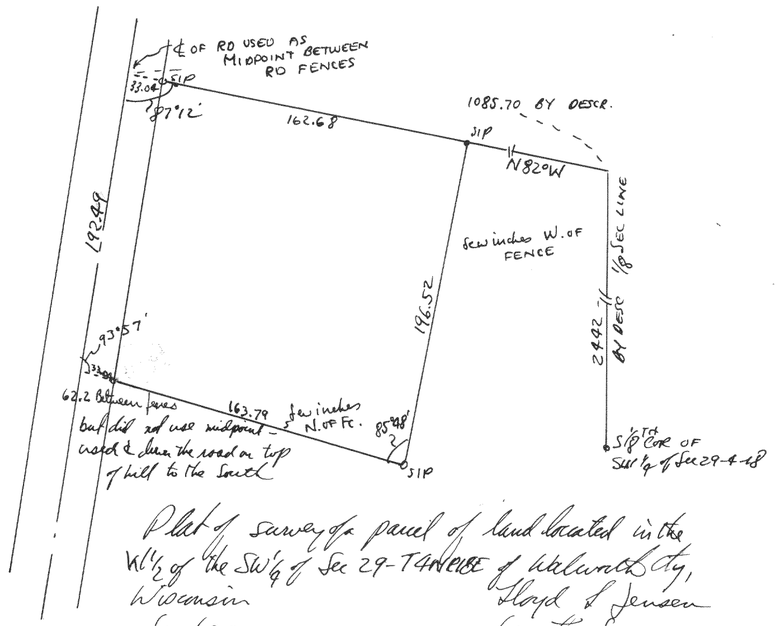

Plat of survey of a parcel of land located in the N1/2 of the SW1/4 of Sec 29-T4NR18E of Walworth County, Wisconsin
Sept 29, 1950

Floyd L. Jensen
County Surveyor


#2271

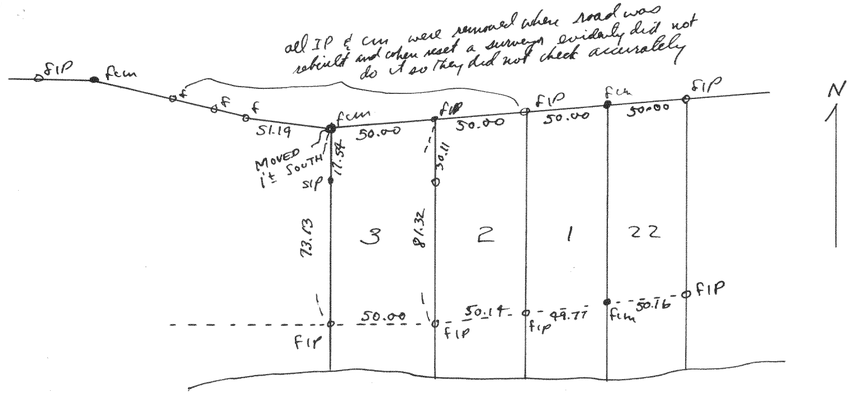

Plat of survey of Lot 3, Trenckel's 2ND Subd located in Sec 18, T4NR18E, Walworth County, Wis.
Oct 10, 1950

Floyd L. Jensen
County Surveyor


#2272

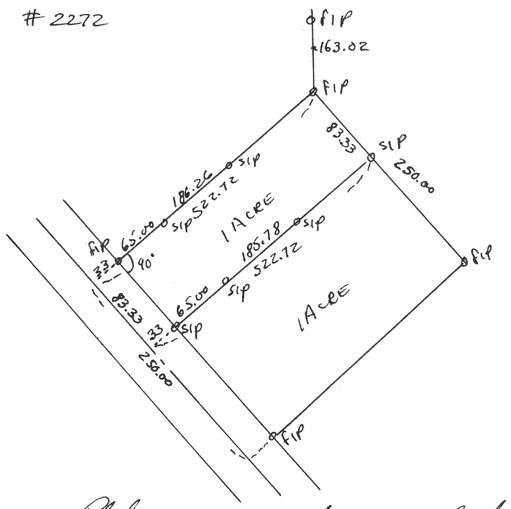

Plat of survey of a 2 acre parcel for Daniels located in the W1/2 of Sec 11, T4NR18E of Walworth County, Wisconsin.
Oct 13, 1950

Floyd L. Jensen
County Surveyor

#2273

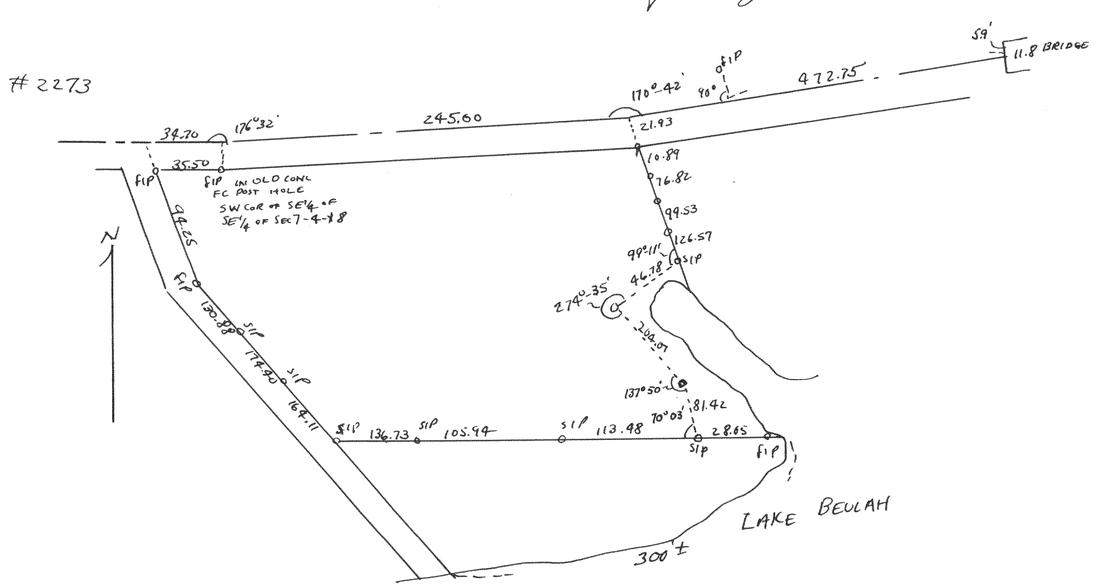

Plat of Survey of Kemble Property located in Sec 7, T4NR18E of Walworth County, Wis.
Nov 10, 1950

Floyd L. Jensen
County Surveyor