2274

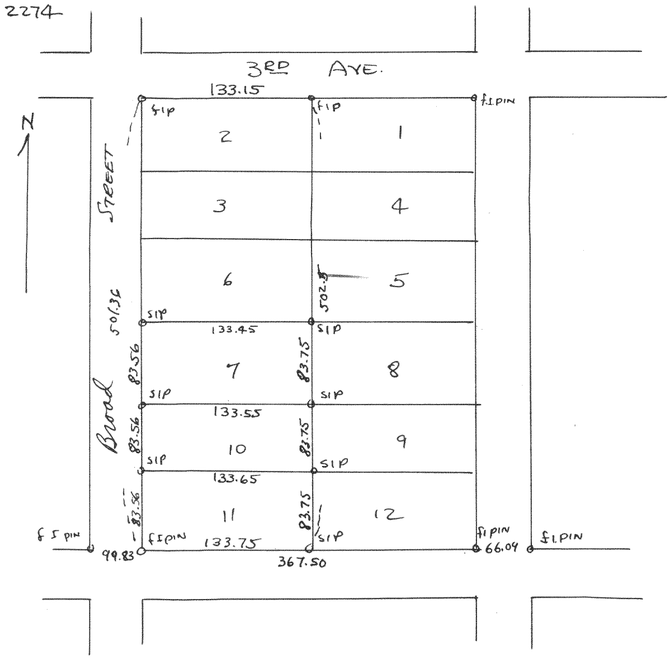

Plat of survey of Lots 7, 10, 11 Block 45 Davis Addition located in the City of Elkhorn Walworth County, Wis.
April 6, 1950

Floyd T. Jensen
County Surveyor

2275

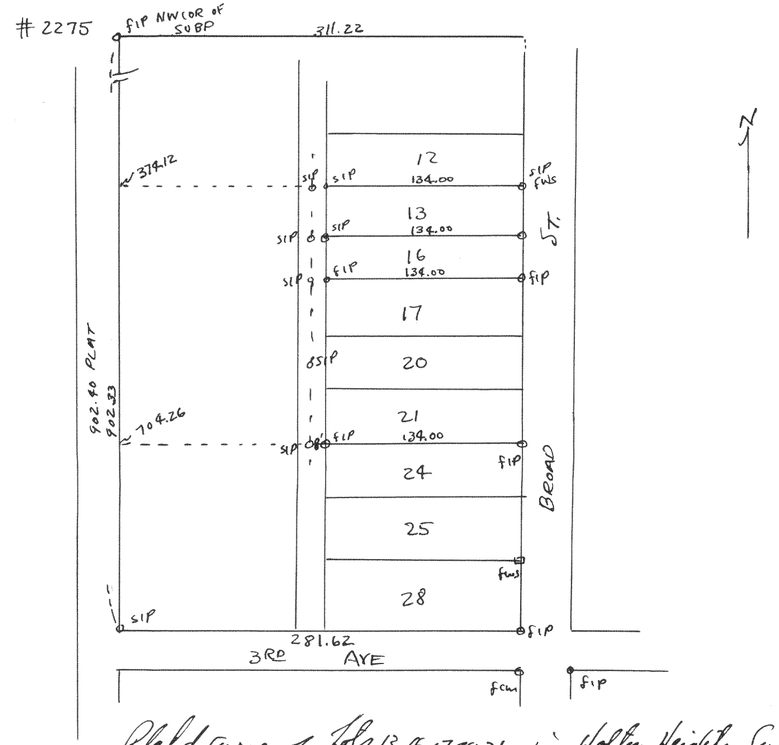

Plat of survey of Lots 13, 16, 17, 20, 21 in Holton Heights Subd located in the City of Elkhorn Walworth County, Wis.
April 6, 1950

Floyd T. Jensen
County Surveyor

BLOCK 2