

# 2274

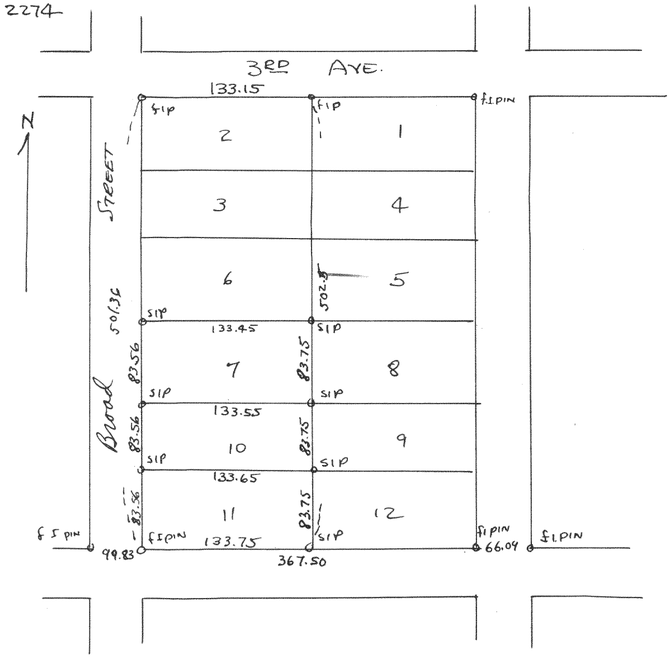


Plat of survey of Lots 7, 10½ 11 Block 45 Davis Addition located in the City of Elkhorn Walworth County, Wis.
April 6, 1950

Lloyd T. Jensen
County Surveyor

# 2275

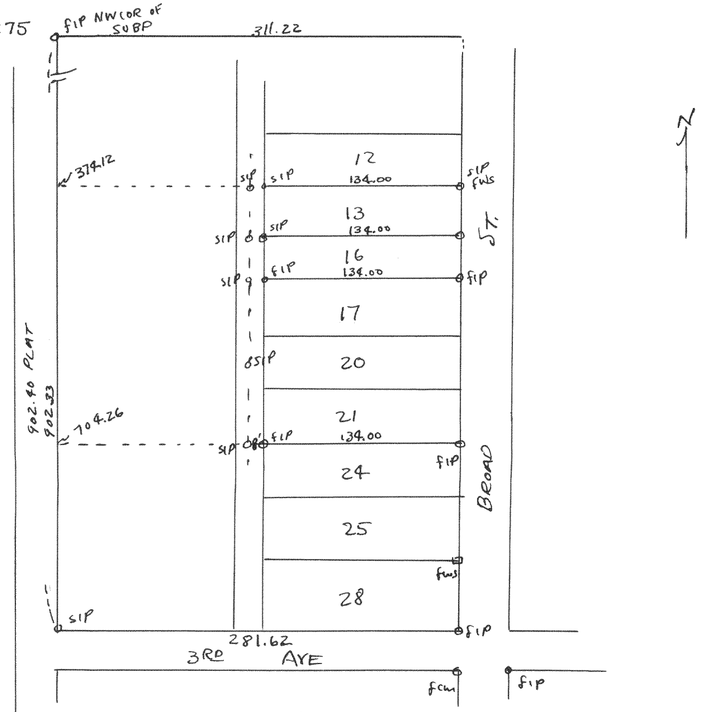


Plat of survey of Lots 13, 16, 17, 20, 21 in Holton Heights Subd located in the City of Elkhorn, Walworth County, Wis.
April 6, 1950

Lloyd T. Jensen
County Surveyor

BLOCK 2