522

#2276

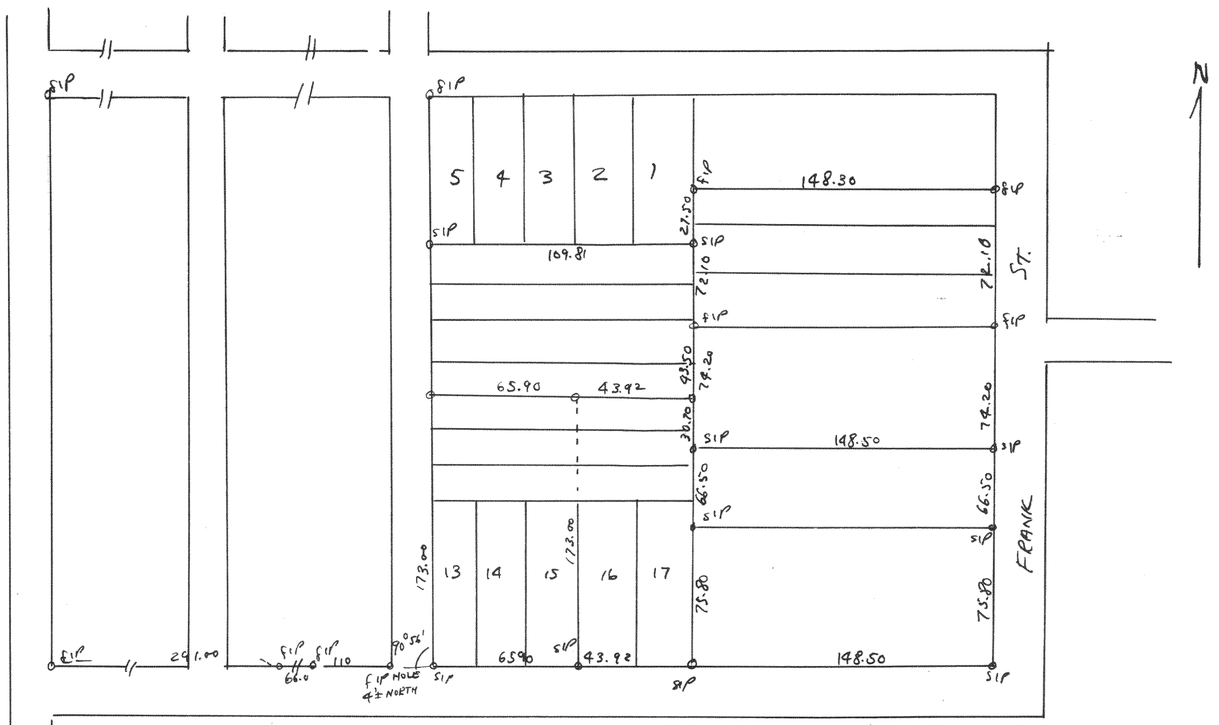

Plat of survey of Part of Lots 6-17, Old, Elkhorn Gardens and parcels for Platts Bros. located East of and adjoining Elkhorn Gardens, City of Elkhorn, Walworth County, Wis.
1950

Lloyd L. Jensen
County Surveyor