

#2277

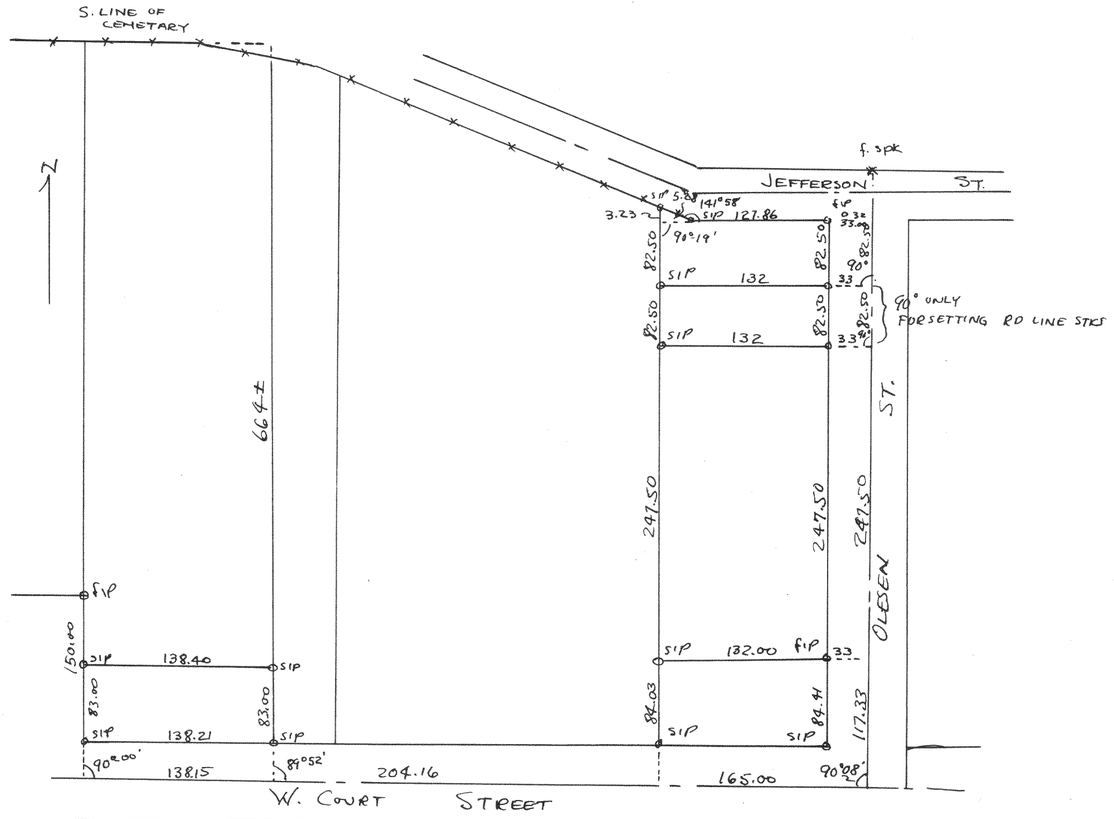

Plat of survey of parcels of land for Karavoskis located in the City of Elkhorn, Walworth County, Wisconsin
July 25, 1950

Lloyd T. Jensen
County Surveyor

#2278

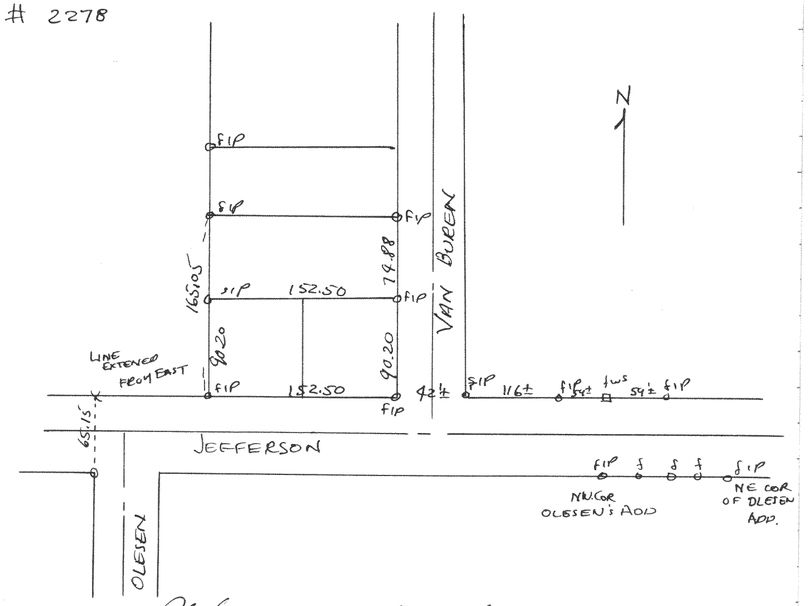

Plat of survey of Cooper land located in SE¼ Sec 36 T3N R16E City of Elkhorn, Walworth County, Wis.
July 25, 1950

Lloyd T. Jensen
County Surveyor