

524

#2279

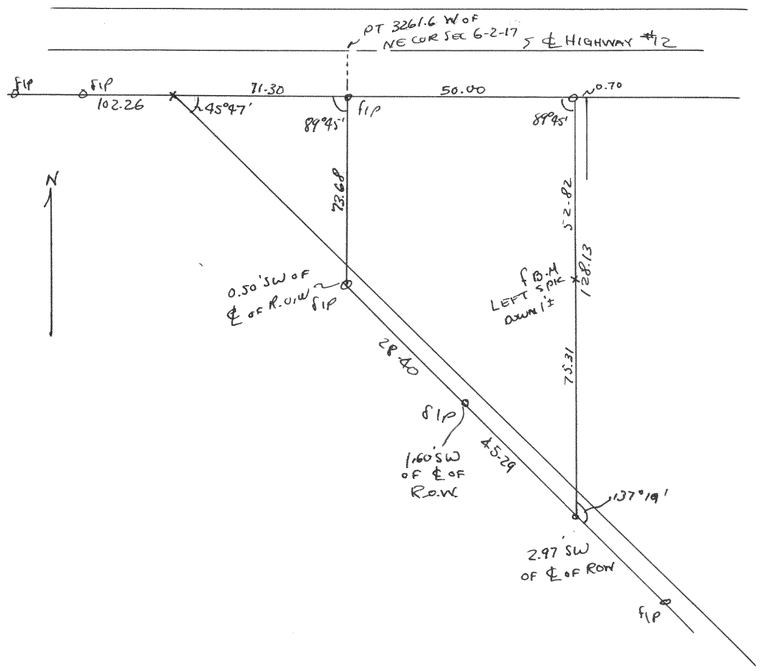

Plat of survey of the Gas Company Property located in Sec 6, T2NR17E, City of Elkhorn, Walworth County, Wisconsin
Aug 31, 1950
Floyd D. Jensen
County Surveyor

#2280

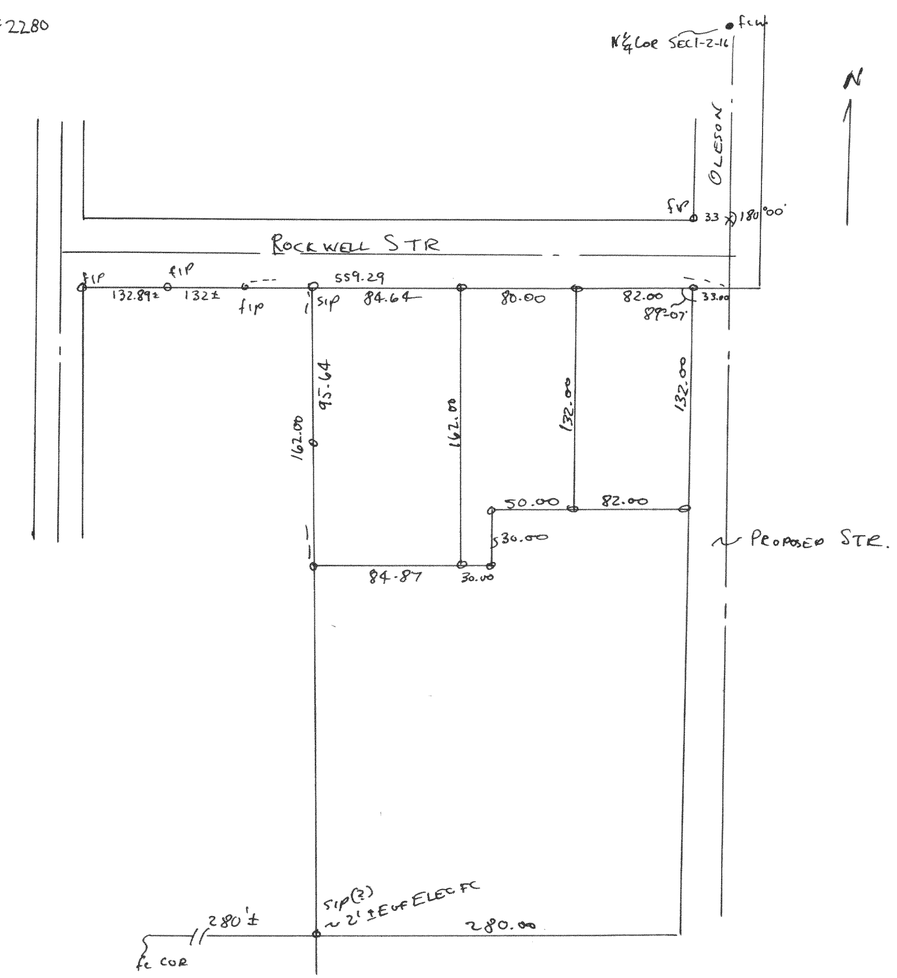

Plat of survey of the Satchell property purchased by Jennings located in Section 1, T2NR16E, City of Elkhorn, Walworth County, Wis.
Oct 3, 1950
Floyd D. Jensen
County Surveyor