

#2281

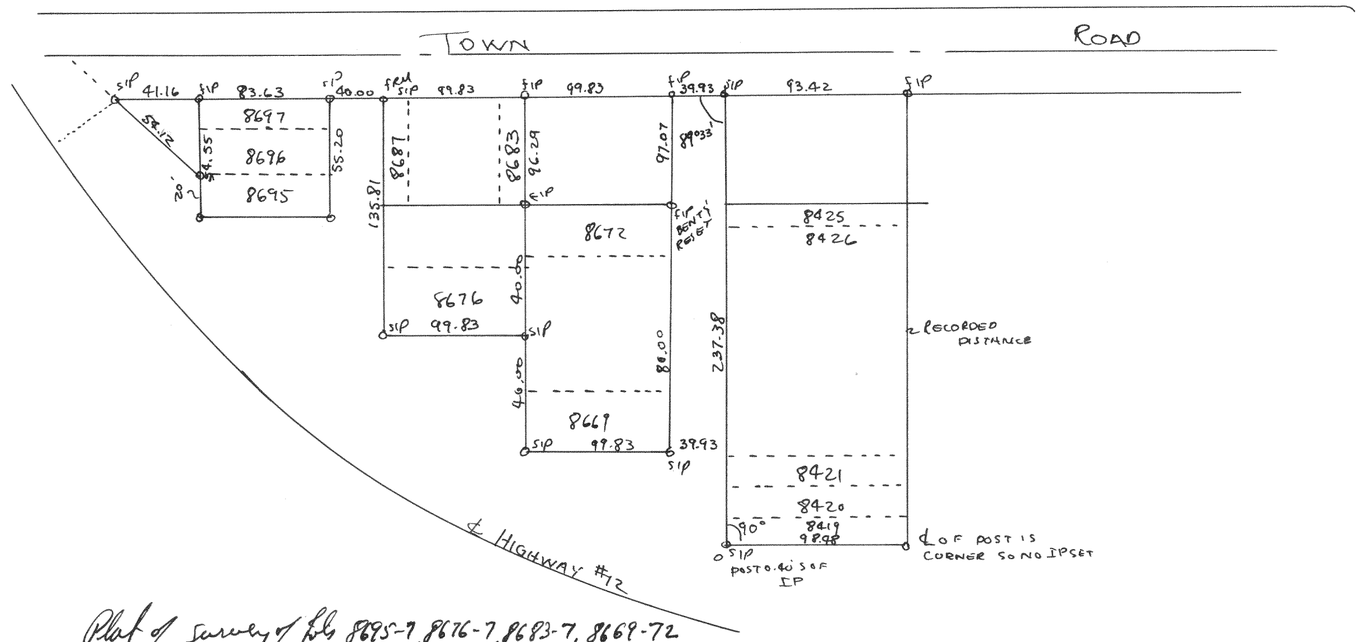

Plat of survey of Lots 8695-7, 8676-7, 8683-7, 8669-72
8419-8430 of Lake Como Beach Subd. located in Sections 21 & 22
T2NR17E of Walworth County, Wis.
Aug 28, 1950

Floyd L. Jensen
County Surveyor

#2282

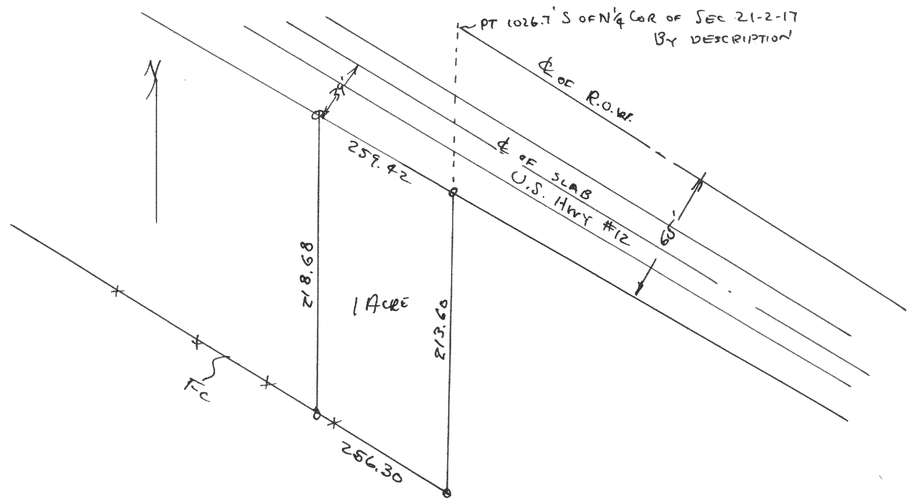

Plat of survey of a 1 acre parcel of land located in the NW¼ of Sec 21, T2NR17E, Walworth County, Wis.
Aug 3, 1950

Floyd L. Jensen
County Surveyor