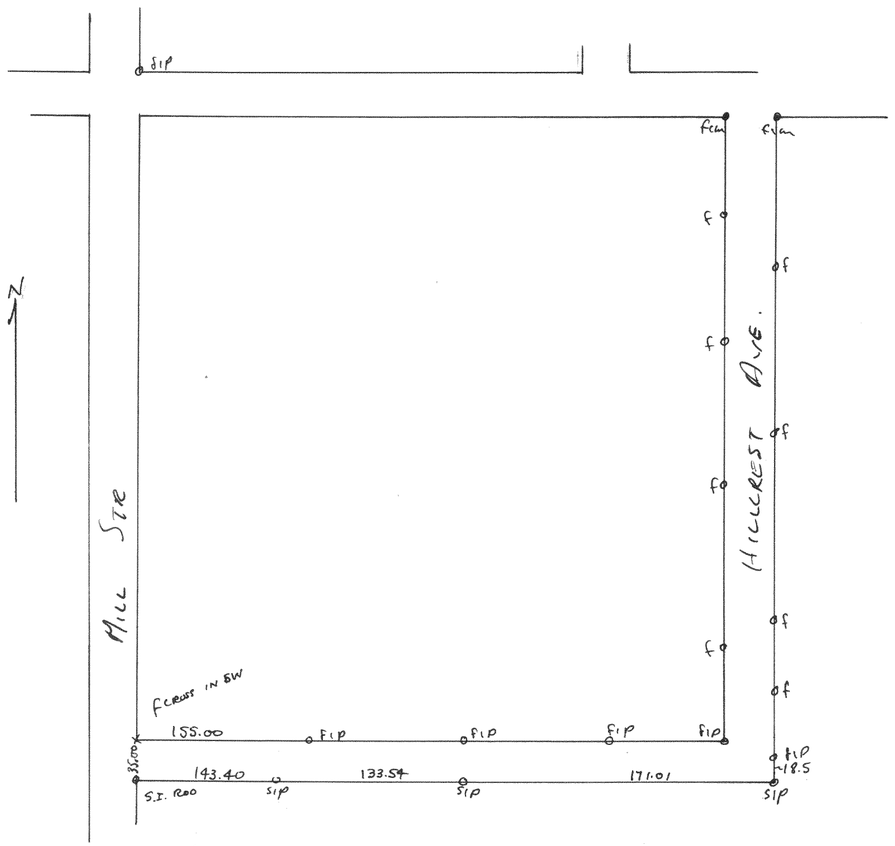
#2285


SIP
Fcor
F
F
F