
528


#2287

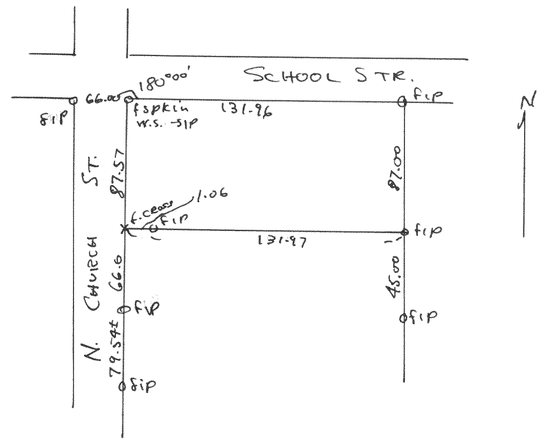

Plat of survey of part of Lot 2, Blk 5 of the original town, Village of East Troy, Walworth Co., Wis.
Oct 10, 1950

Floyd L. Jensen
County Surveyor


#2288

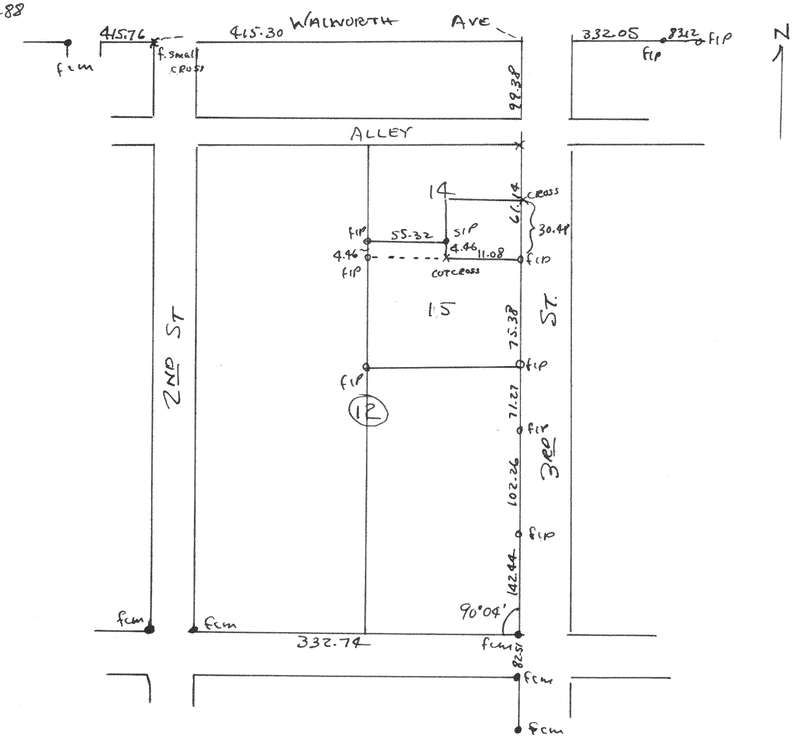

Plat of survey of parts of lots 14 & 15, Block 12 City of Delavan, Walworth County, Wis.
1950

Floyd L. Jensen
County Surveyor

#2289

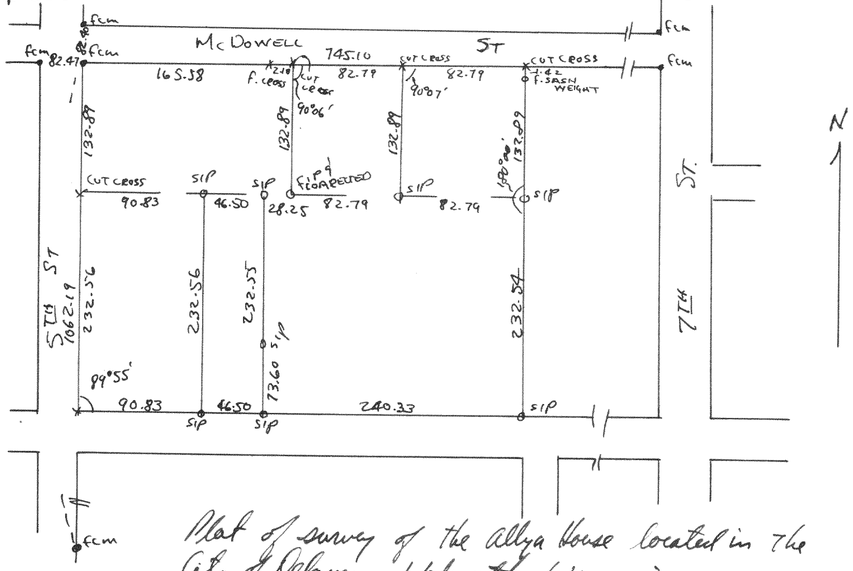

Plat of survey of the Allyn House located in the City of Delavan, Walworth Wisconsin.
July 19, 1950

Floyd L. Jensen
County Surveyor