

2290

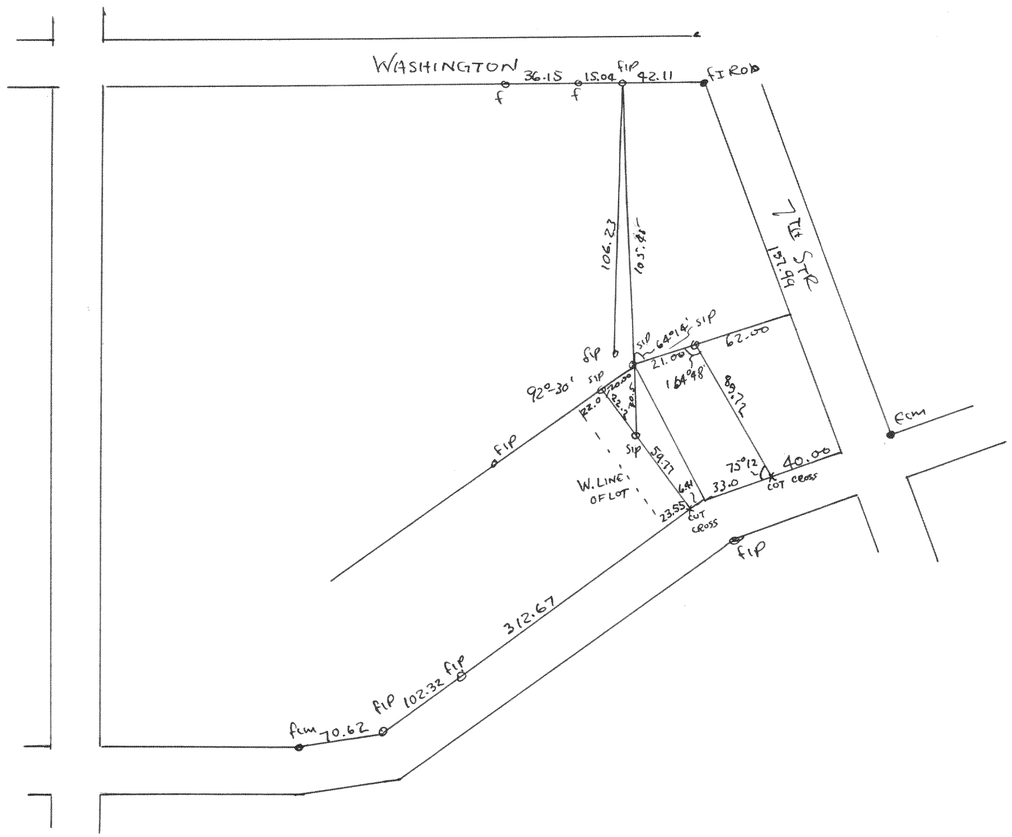

Sept 1950

Floyd L. Jensen
County Surveyor

2291

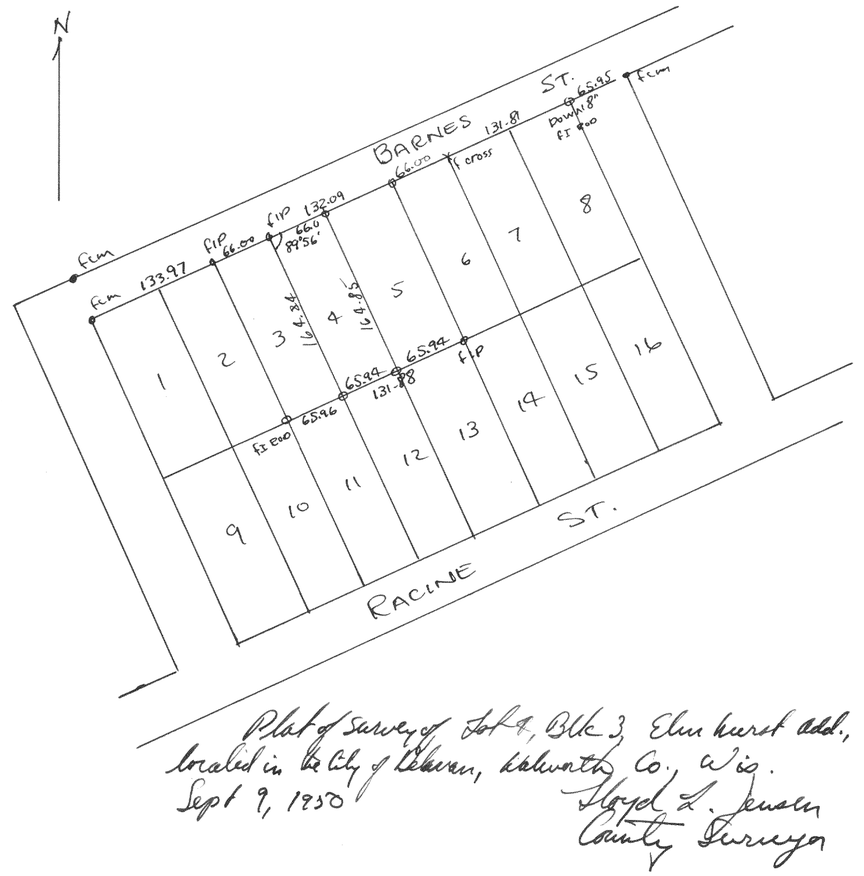

Sept 9, 1950

Floyd L. Jensen
County Surveyor