2290

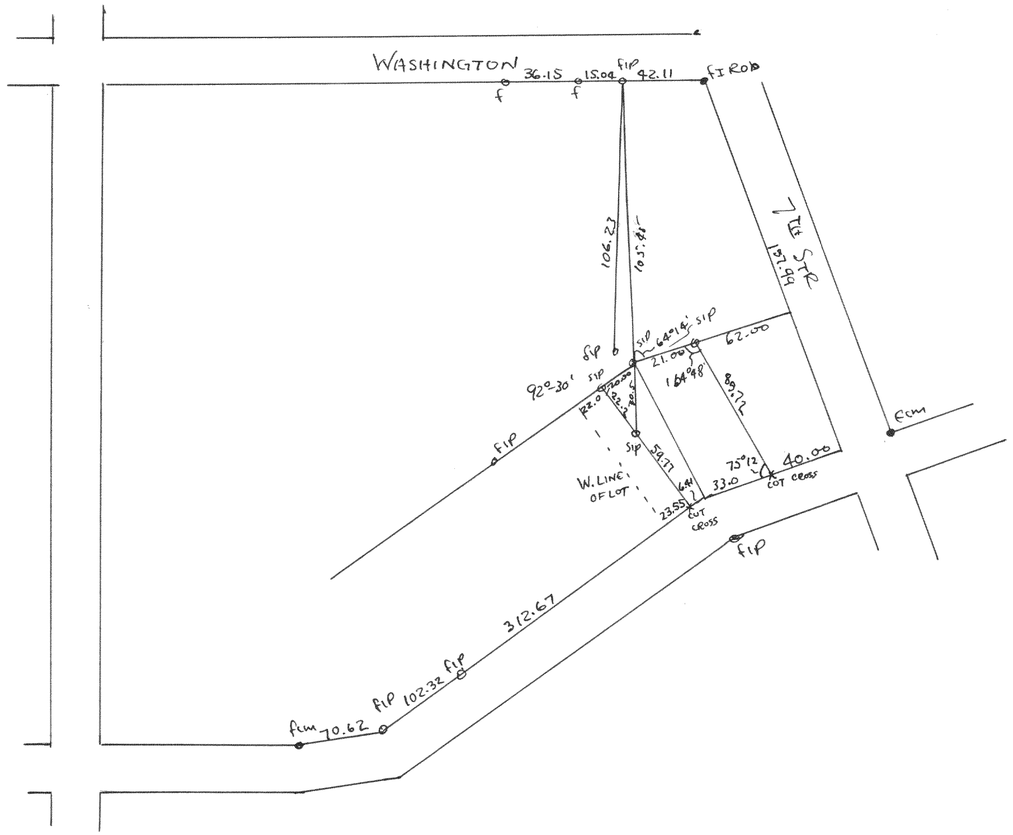

Plat of survey of part of Lots 19 & 20, Blk 8, Passage, Aram & Downes Addition, City of Elkhorn, Walworth Co., Wis.
Sept 1950

Floyd L. Jensen
County Surveyor

2291

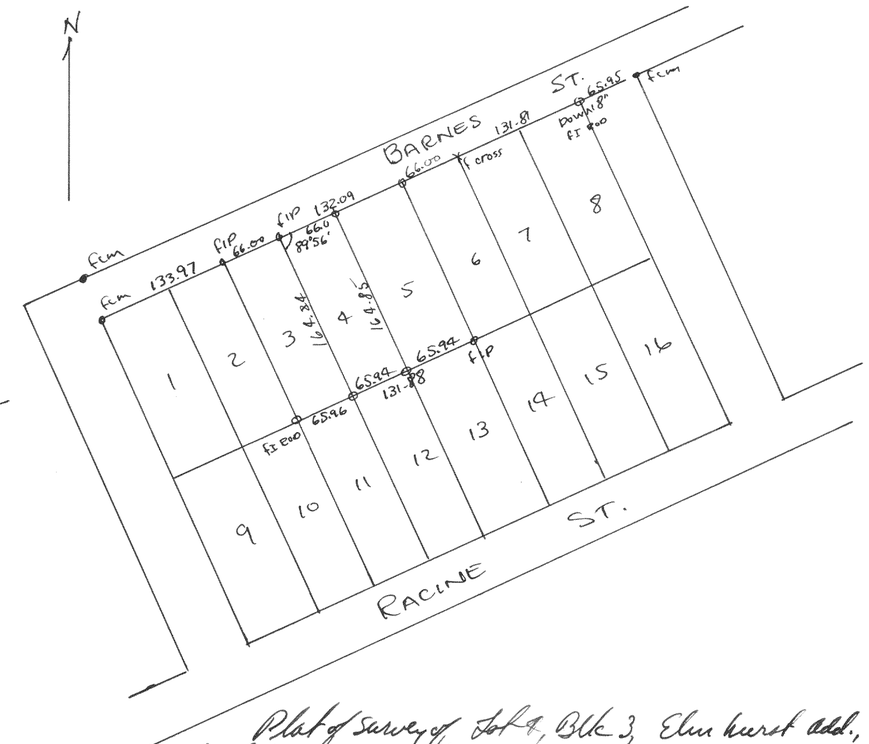

Plat of survey of Lot 9, Blk 3, Elmhurst Add., located in the City of Elkhorn, Walworth Co., Wis.
Sept 9, 1950

Floyd L. Jensen
County Surveyor