

2295

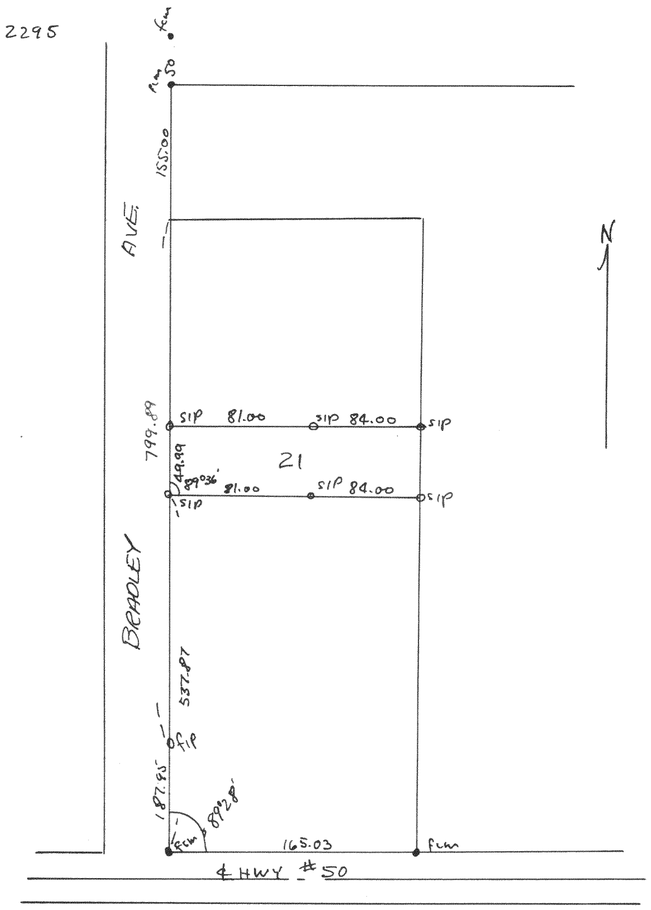

Plat of survey of Lot 21 of Tyrrell Subd located in the City of Delavan, Walworth Co., Wis.
Nov 13, 1950

Lloyd L. Jensen
County Surveyor

2296

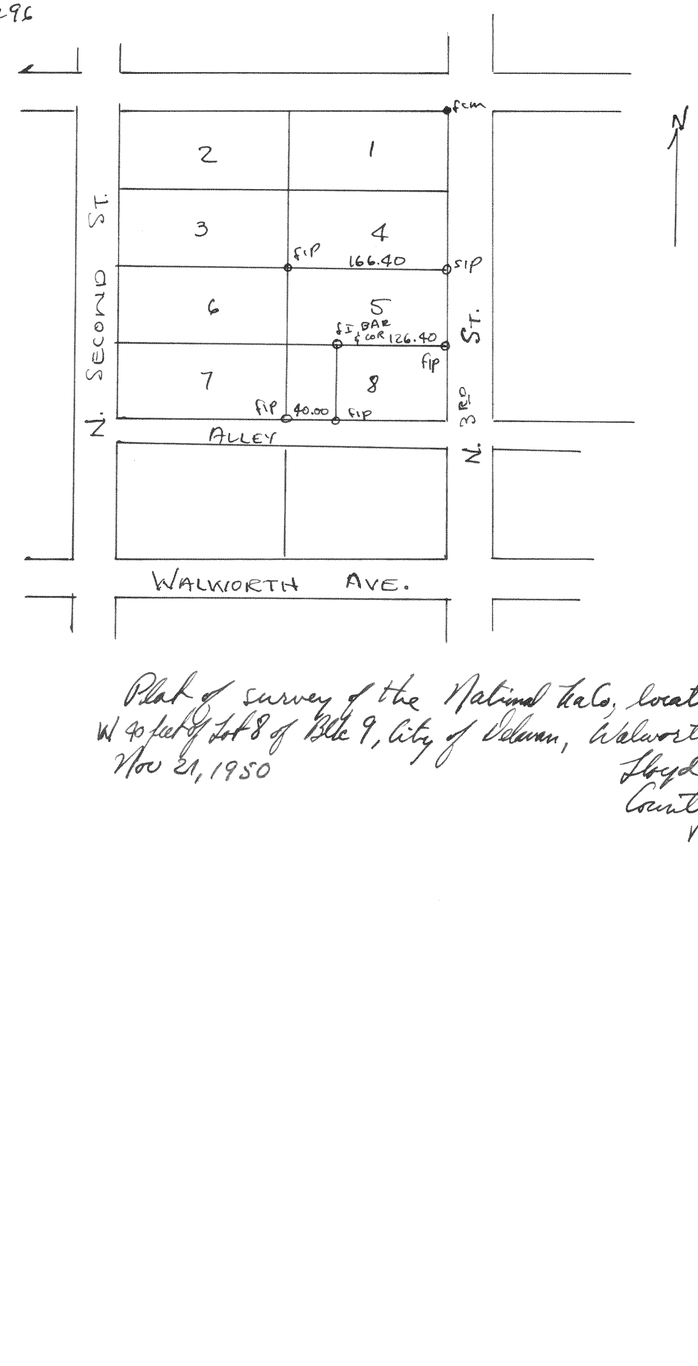

Plat of survey of the National Bk Co, located in Lot 5 & the W 40 feet of Lot 8 of Blk 9, City of Delavan, Walworth Co., Wis.
Nov 21, 1950

Lloyd L. Jensen
County Surveyor