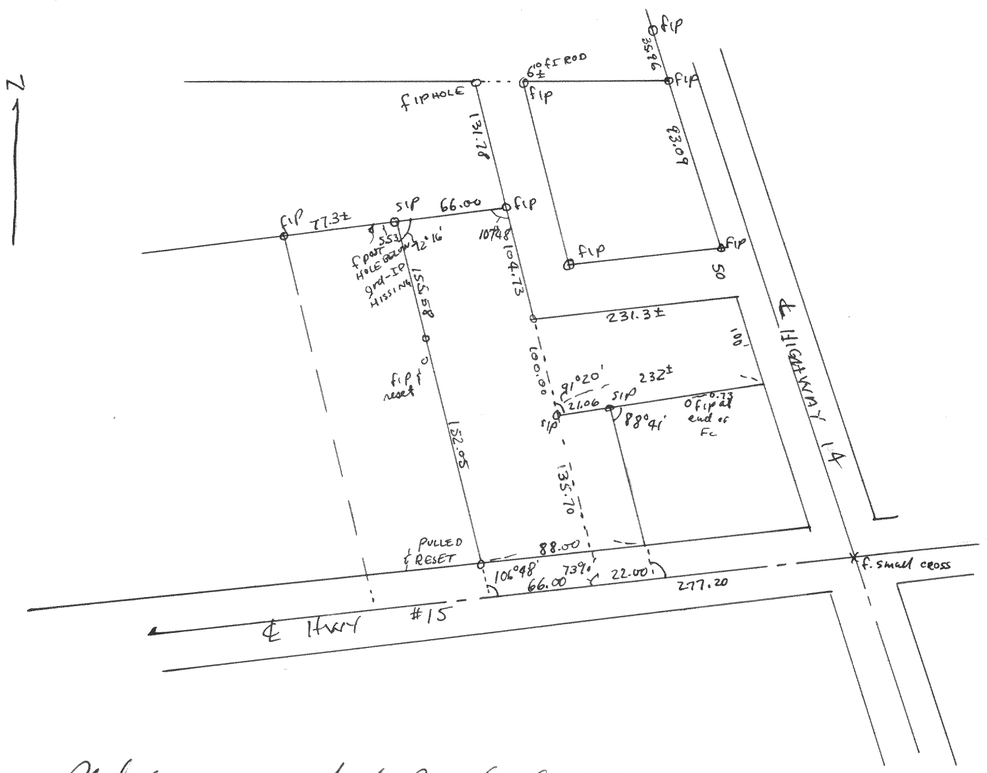
532

#2297


N
fip
fip HOLE
60° ELM ROD
fip
fip
fip