
534


2302

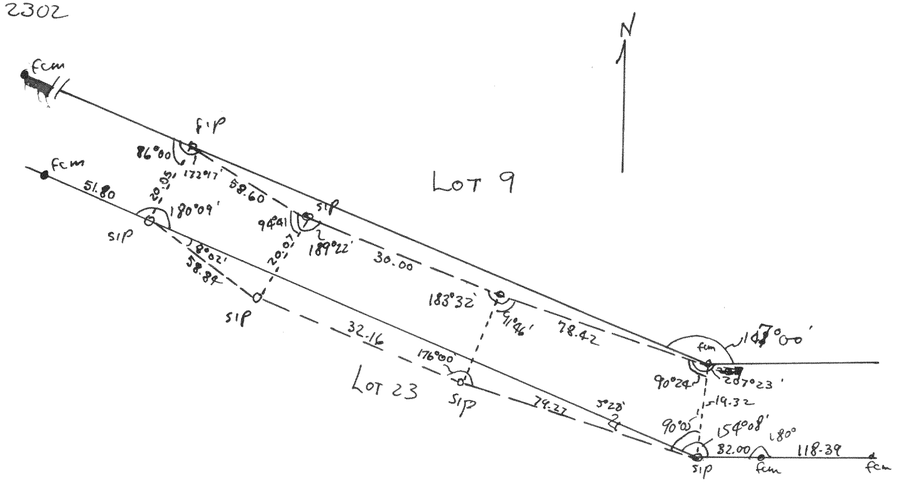

Plat of survey of the road location change between Lots 9 & 23 of the Sanders Subd. located in the NE ¼ of Sec 11, T1N R16E, Village of Fontana, Walworth County, Wisconsin.
1950

Lloyd L. Jensen
County Surveyor


2303

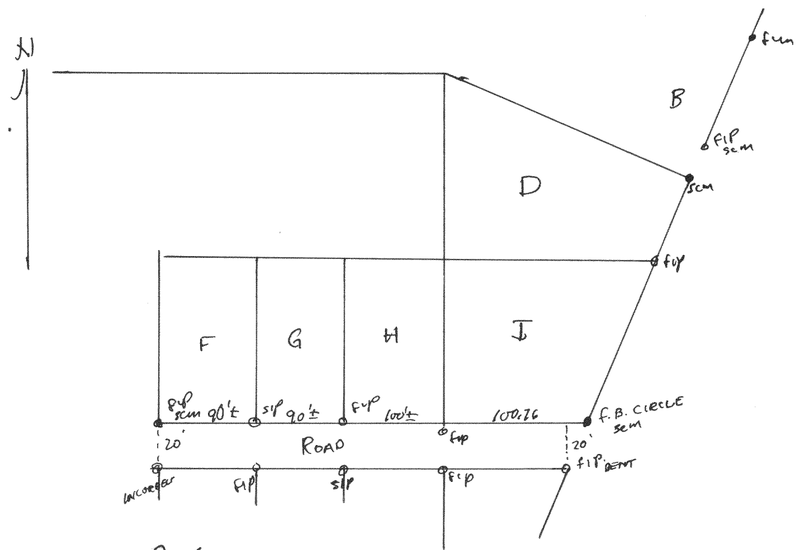

Plat of survey of the W. Road line & path in the upper garden Subdivision located in Sec 11, T1N R16E, Walworth County, Wis.
July 28, 1950

Lloyd L. Jensen
County Surveyor


#2304

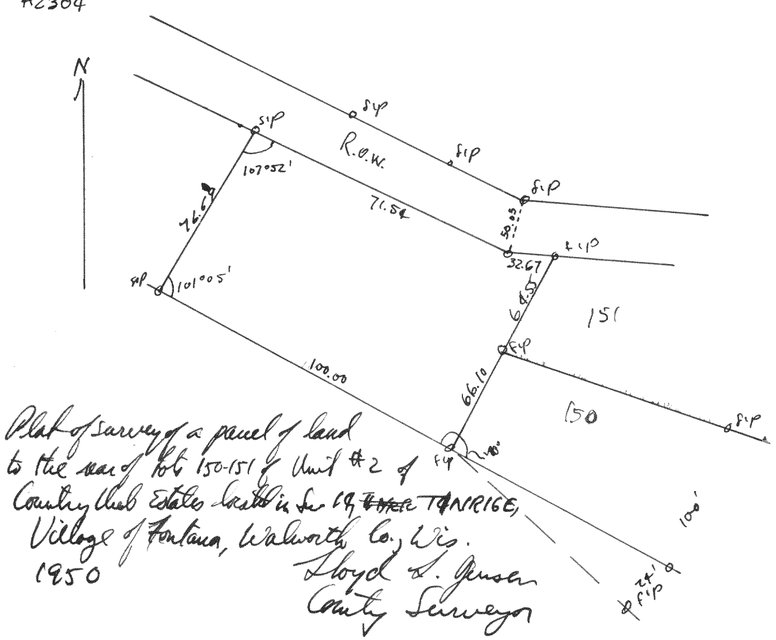

Plat of survey of a parcel of land in the rear of Lots 150-151 of Unit #2 of Country Club Estates located in Sec 19, ~~T1N R16E~~ T1N R16E, Village of Fontana, Walworth Co. Wis.
1950

Lloyd L. Jensen
County Surveyor

2305

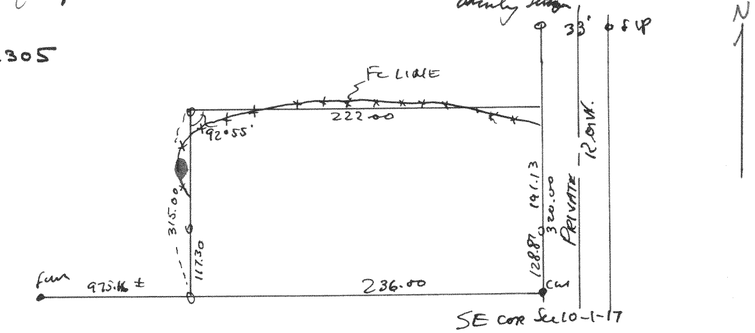

Plat of survey of a parcel of land sold by Fontana to Bridges located in the SE cor of Sec. 10, T1N R16E of Walworth County, Wis.
Aug 26, 1950

Lloyd L. Jensen
County Surveyor