

2306

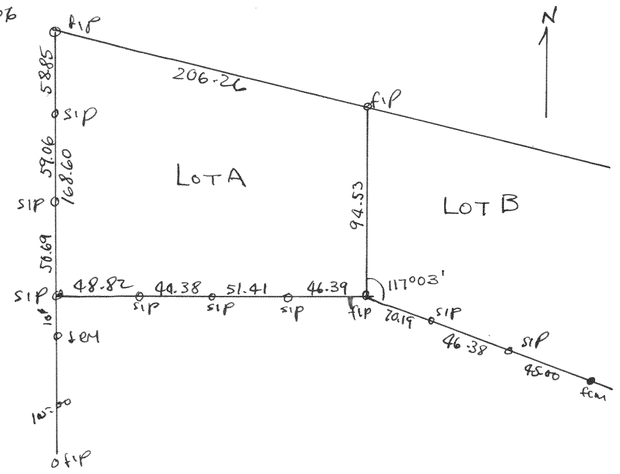

Plat of survey of Lot A & South line Lot B of the Gardens Subd #2 located in Sec 11, T1N R16E of Walworth Co., Wis.
Sept 21, 1950

Floyd D. Jensen
County Surveyor


2307

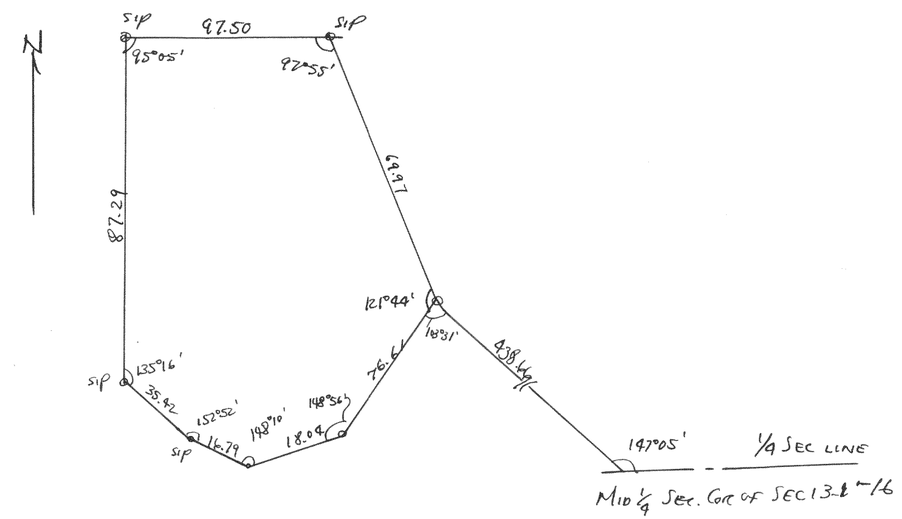

Plat of survey of a parcel of land located in Ayers Park in the NW¼ of Sec 13, T1N R16E, Walworth County, Wis.
Nov 17, 1950

Floyd D. Jensen
County Surveyor

2308

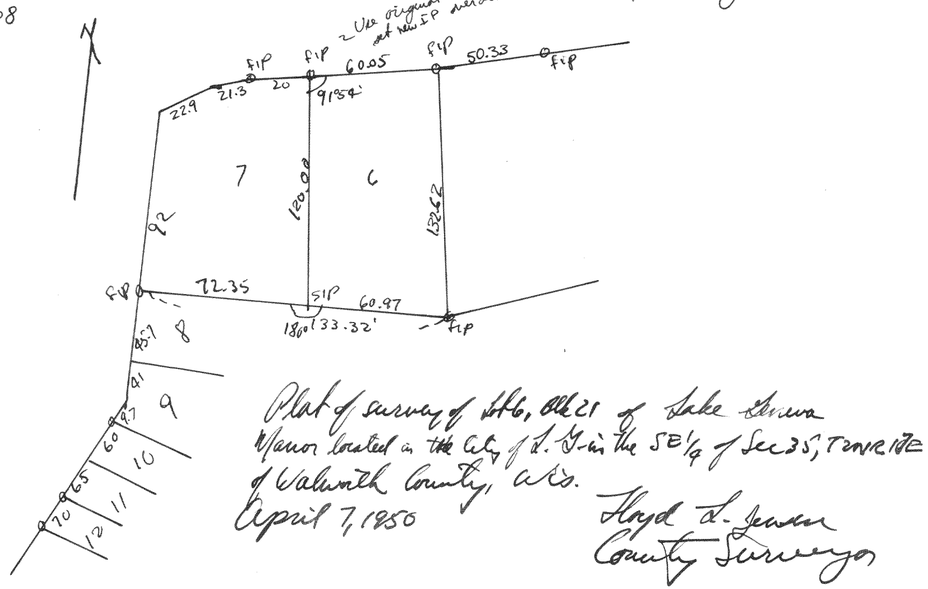

Plat of survey of Lot 6, Blk 21 of Lake Geneva Manor located in the City of L. G. in the SE¼ of Sec 35, T2N R17E of Walworth County, Wis.
April 7, 1950

Floyd D. Jensen
County Surveyor