

2311

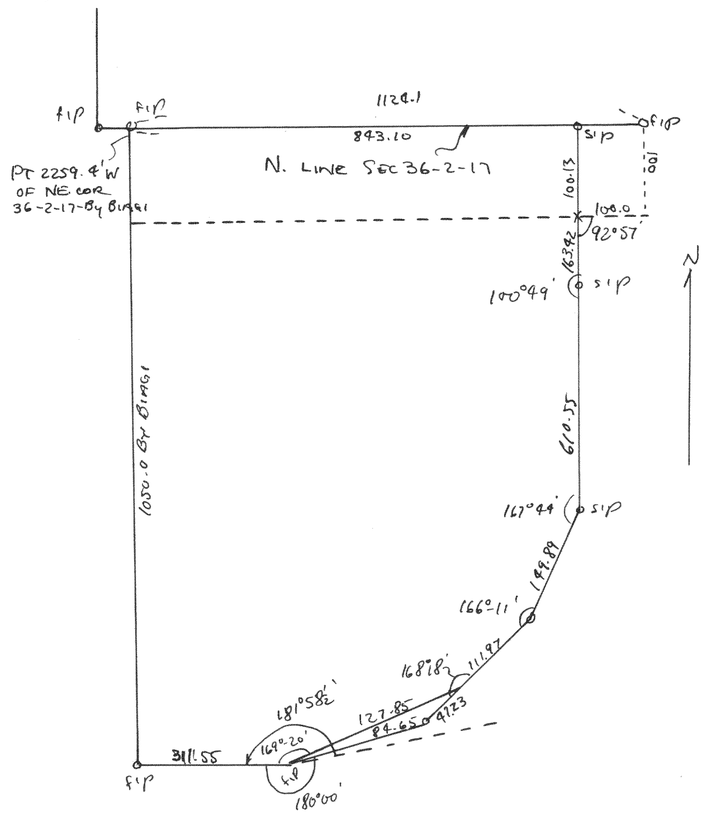

Plat of survey of the Lake Geneva School including athletic Field located in Sec 36, T2N R17E of Walworth Cty., Wis.
November 29, 1950

Lloyd L. Jensen
County Surveyor

2312

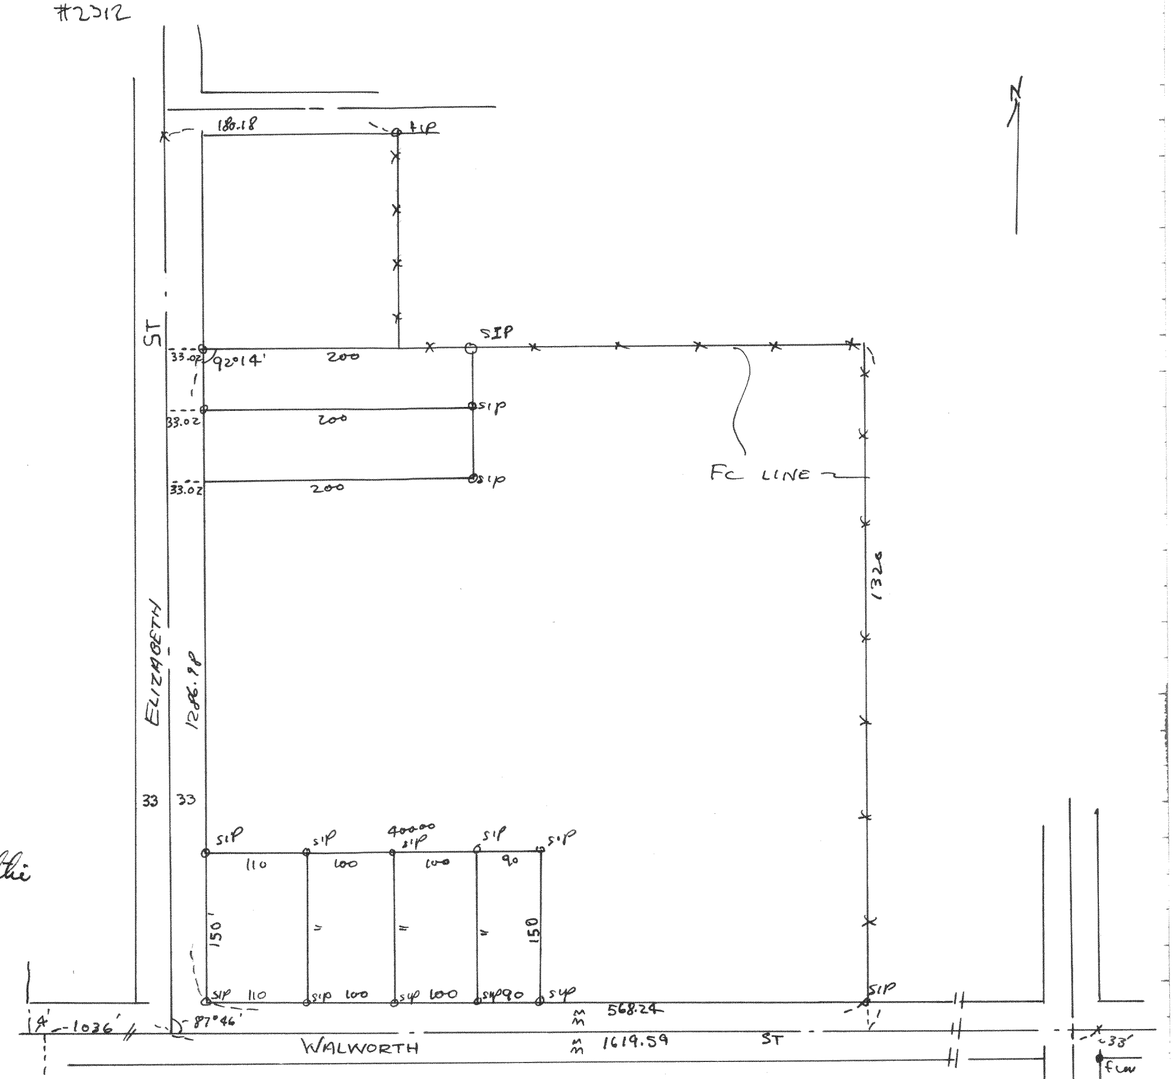

Plat of survey of parcels of land on the Tessene Property located in the SW¼ of Sec 4 T4N R15E of Walworth Cty., Wis.
1950

Lloyd L. Jensen
County Surveyor