
538


2313

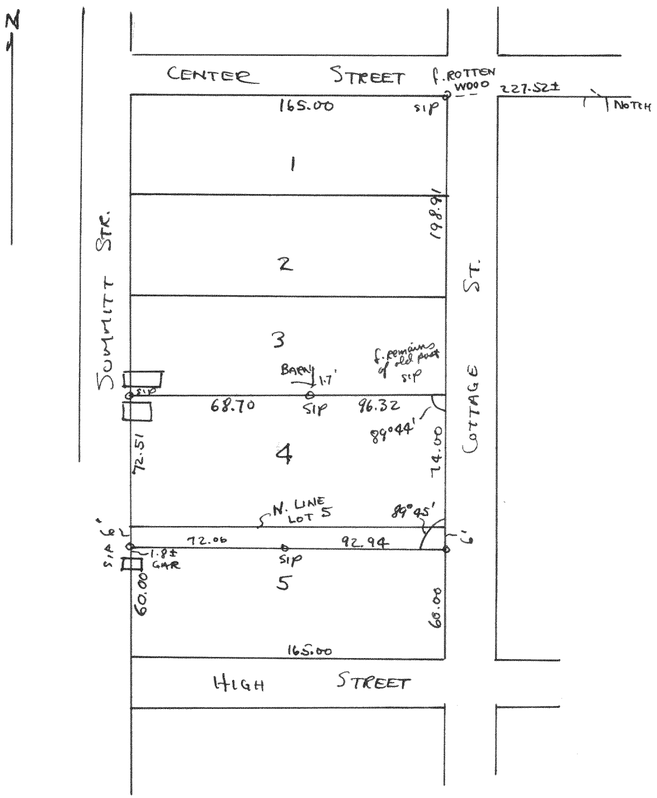

Plat of survey of Lot 4 and the N 6' of Lot 5 of Blk 19 of Chapman's Leading this's Add'n in the City of Whitewater in the SE¼ of Sec 5, T4N R15E, of Walworth Cty., Wis.
Sept 22, 1950

Lloyd D. Jensen
County Surveyor

2314

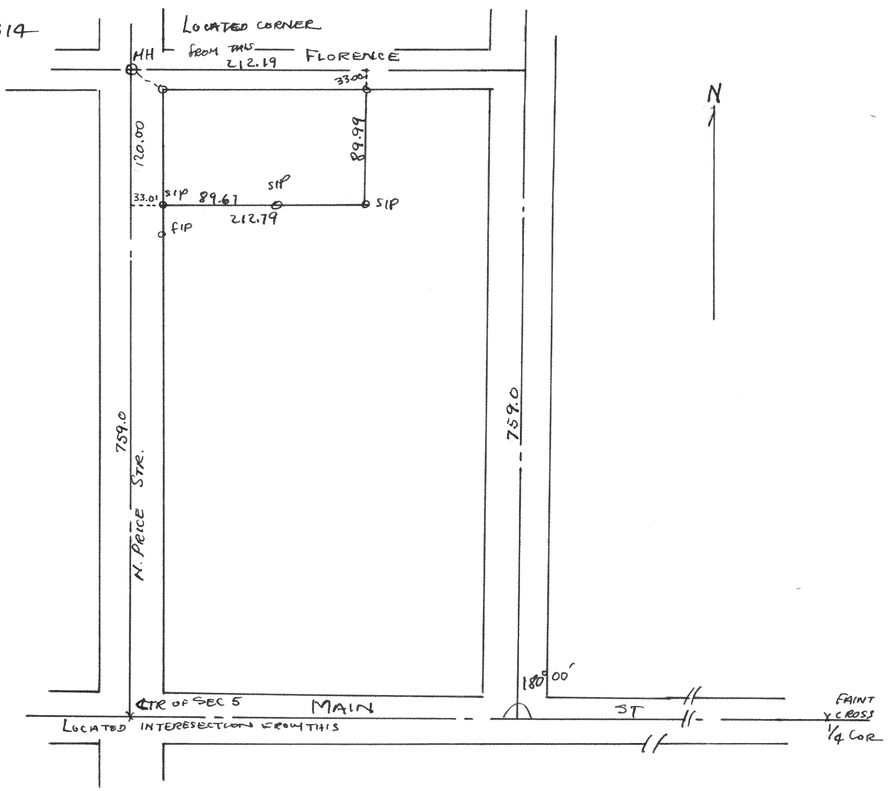

Plat of survey of a parcel of land located at the corner of Florence and N. Pierce Strs. located in the City of Whitewater Walworth Co., Wis.
Oct 27, 1950

Lloyd D. Jensen
County Surveyor