#2315

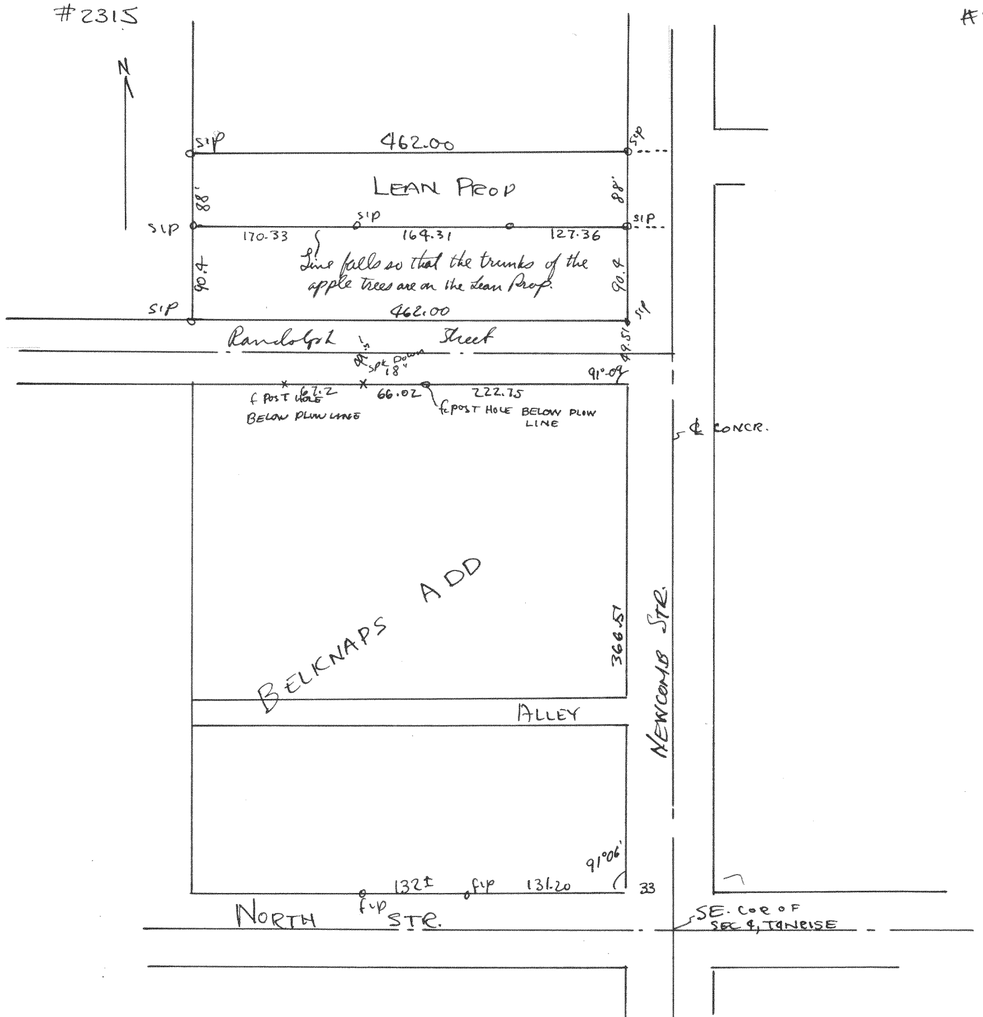

Plat of survey parcel of land owned by Lean and located in SE ¼ Section 9, T4N R15E, City of Whitewater, Walworth County, Wis.
Nov 16, 1950

Floyd S. Jensen
County Surveyor

#2316

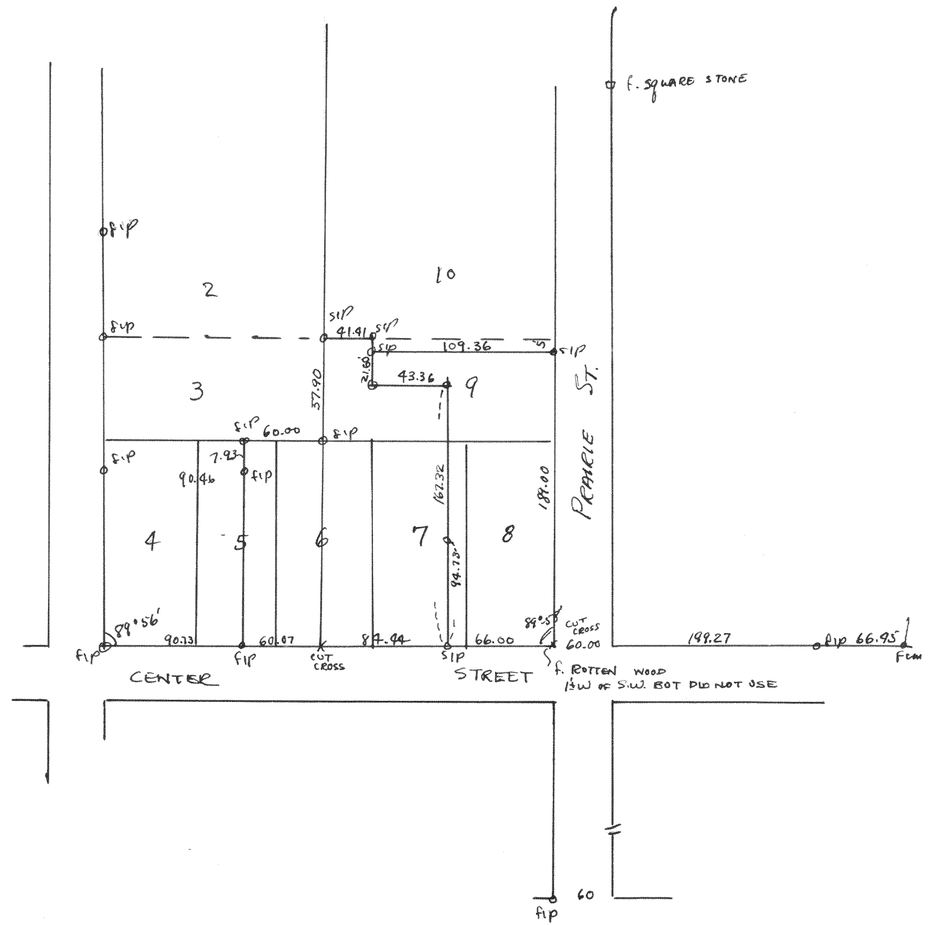

Plat of survey of parts of Lots 6, 7, 8, & 9 of Block 17 Chapman & Sudington's Add. City of Whitewater, Walworth County, Wis.
Nov 17, 1950

Floyd S. Jensen
County Surveyor