

540

2317

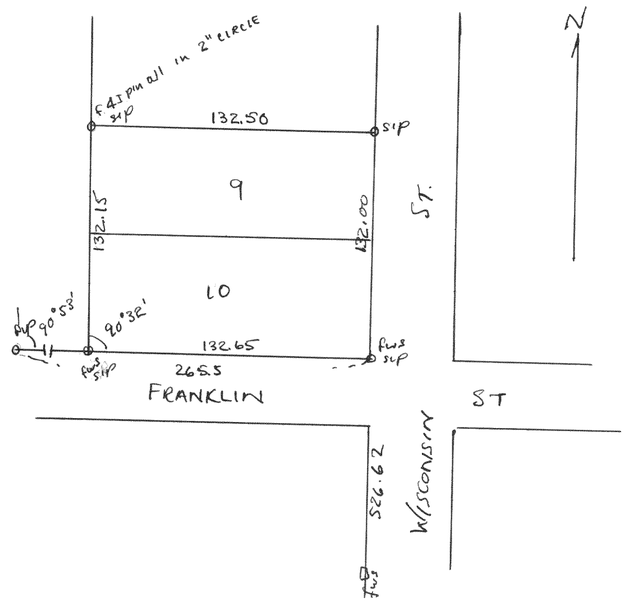

Plat of survey of Lots 9 & 10 of Giffords Add located in the NE ¼ Section 35, T1N R13E Sioux City, Walworth County, Wis.
Floyd L. Jensen City Surv.


2318

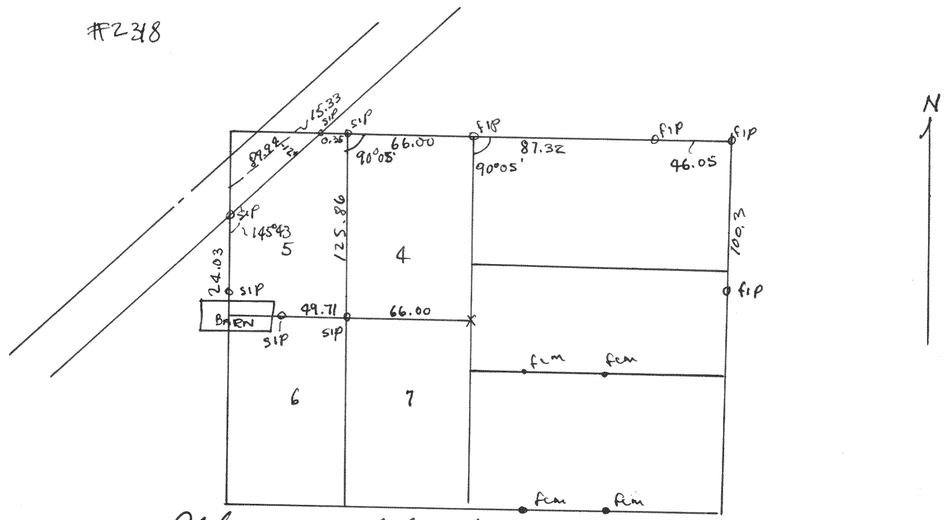

Plat of survey of part of Lot 5 of the Original Town located in Sioux City Walworth County, Wis.
1950

Floyd L. Jensen
County Surveyor


2319

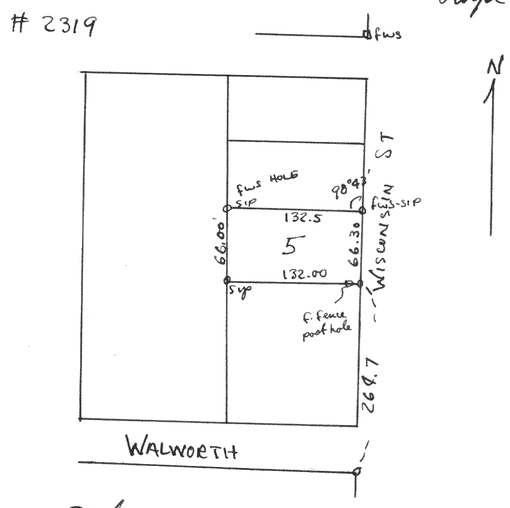

Plat of survey of part of Lot 5, Framan's 2nd Add located in Sioux City, Walworth Co. Wis.
1950

Floyd L. Jensen
County Surveyor

2320

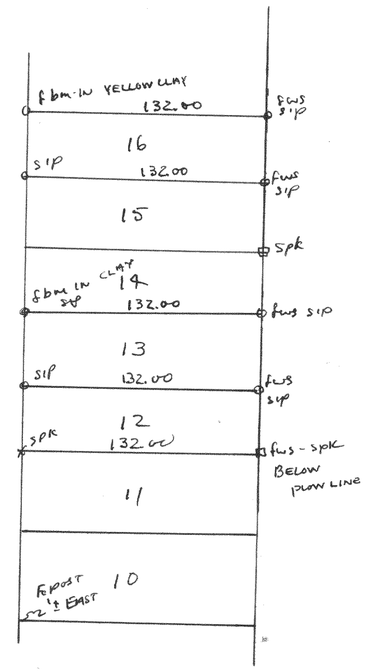

Plat of survey of Lots 13-16 incl., Miller Addition Sioux City, Walworth County, Wis.
Oct 28, 1950

Floyd L. Jensen
County Surveyor