
542


#2325

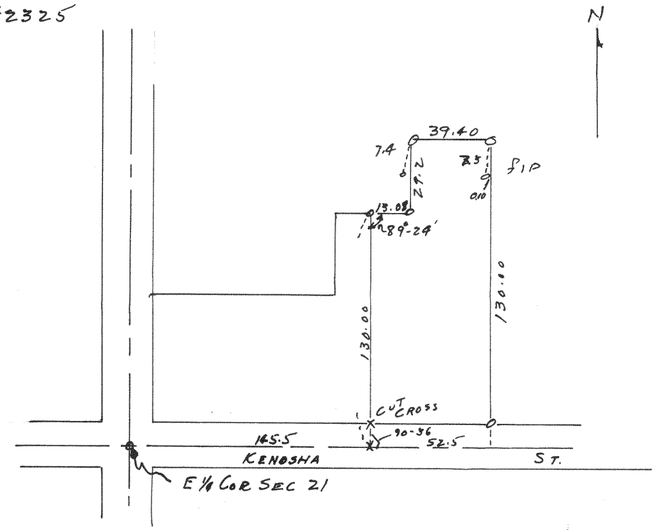

Plat of survey of the Brostrock Property located on Kenosha Ave 165.5 East of E ¼ Cor of Section 21 T1N R16E Village of Walworth Walworth County Wis 1950

Floyd F. Jensen (CWS)
County Surveyor


#2326

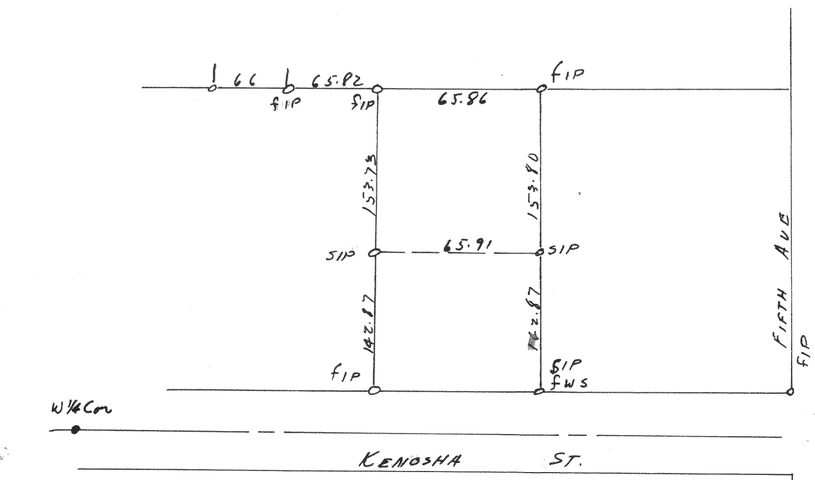

Plat of survey of O.L. 182 Village of Walworth, Walworth County, Wis. Aug 19, 1950

Floyd F. Jensen (CWS)
County Surveyor


#2327

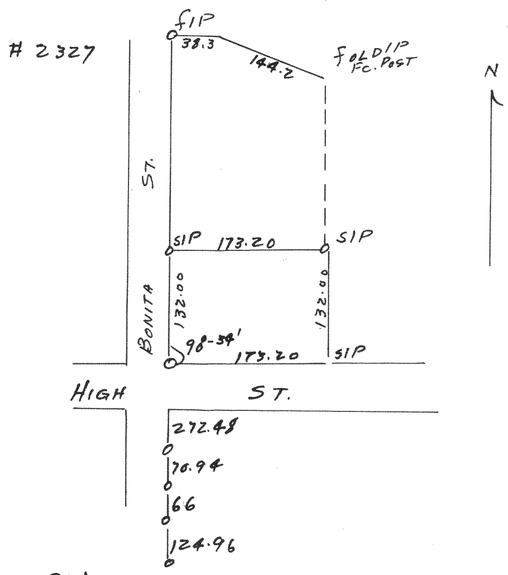

Plat of survey of part of O.L. 196 Village of Walworth Walworth County, Wis Oct. 25, 1950

Floyd F. Jensen (CWS)
County Surveyor

#2328

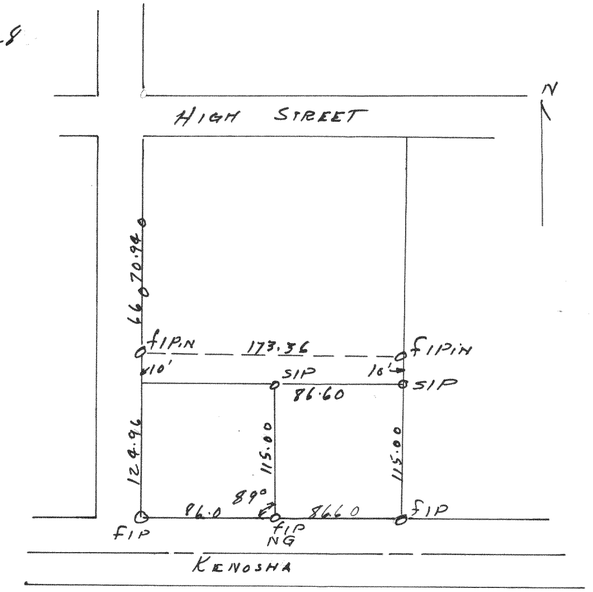

Plat of survey of part of O.L. 196 Village of Walworth Walworth County, Wis. Nov. 1950

Floyd F. Jensen (CWS)
County Surveyor