

2333

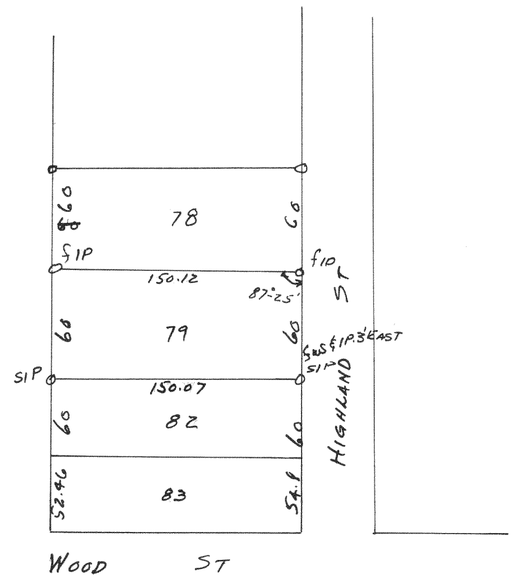

Plat of survey of lot 79 of Bay View Subd.
located in the SE¼ of Sec 1 T1N R16E Village of Williams Bay
Walworth County, Wis.
July 7, 1950

Lloyd L. Jensen (Surv.)
County Surveyor


2334

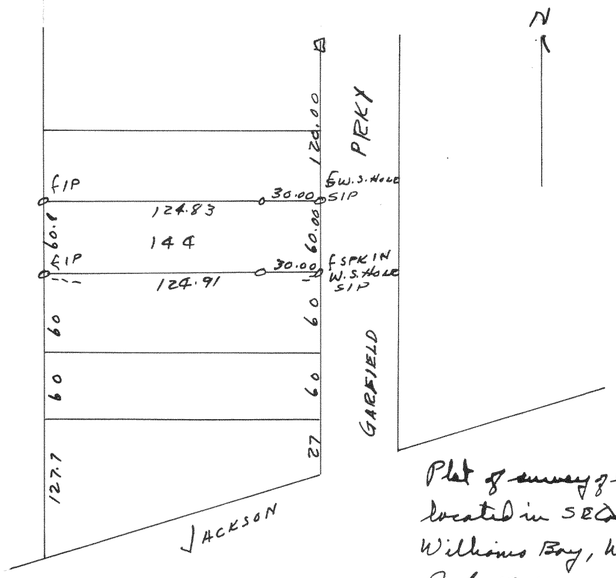

Plat of survey of lot 144 of Cedar Point Park Original Subd
located in SE¼ of Sec 6 T1N R17E, Village of
Williams Bay, Walworth County, Wis
July 14, 1950

Lloyd L. Jensen (Surv.)
County Surveyor


2335

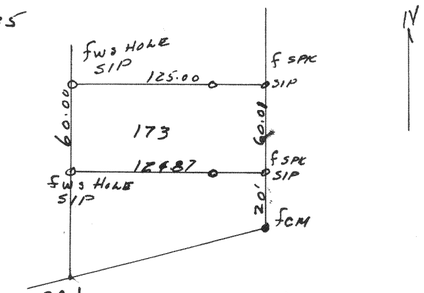

Plat of survey of lot 173 of Cedar Point Park Original Subd
located in the SE 1/4 of sec 6 T1N R17E, Village of Williams Bay
Walworth County Wis.
July 31, 1950

Lloyd L. Jensen (Surv.)
County Surveyor

2336

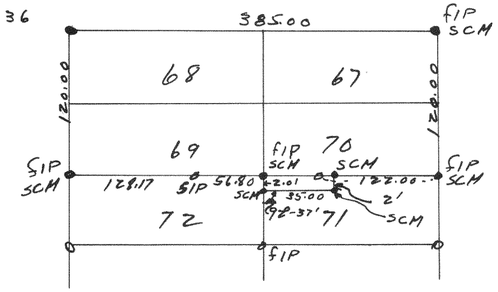

Plat of survey of lots 67, 68, 69 & 70 of Bay View Subd located in the
SE 1/4 of Sec 1 T1N R16E Village of Williams Bay, Walworth County, Wis
Aug 1, 1950

Lloyd L. Jensen (Surv.)
County Surveyor