
2337

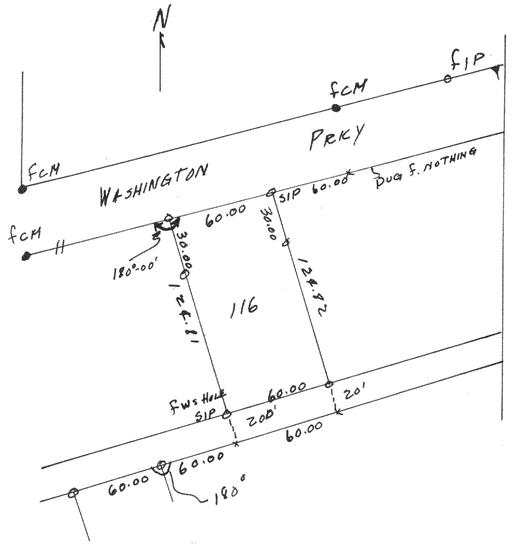


Plat of survey of lot 116 of Cedar Point Park original subd. located in the S.E¼ of Sec. 6 T1N R17E, Walworth County, Wis.

Aug 2, 1950

Lloyd T. Jensen (CWS)
County Surveyor

2338

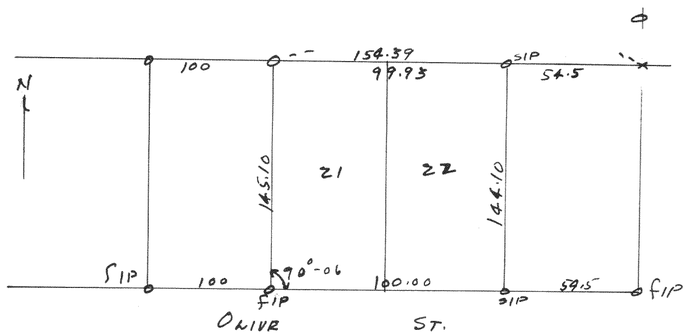


Plat of survey of lots 21 & 22 Blk 1 of Lake Subd located in the NE¼ of Sec. 1 T1N R16E, Village of Williams Bay, Walworth County, Wis.

Aug 10, 1950

Lloyd T. Jensen (CWS)
County Surveyor

2339

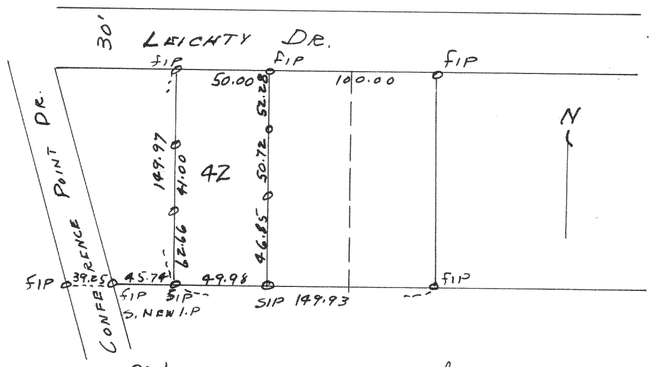


Plat of survey of lot 42 Summer Haven Subd. located in SE¼ of Sec 1 T1N R16E Village of Williams Bay Walworth County, Wis.

Sept 9, 1950

Lloyd T. Jensen (CWS)
County Surveyor

2340

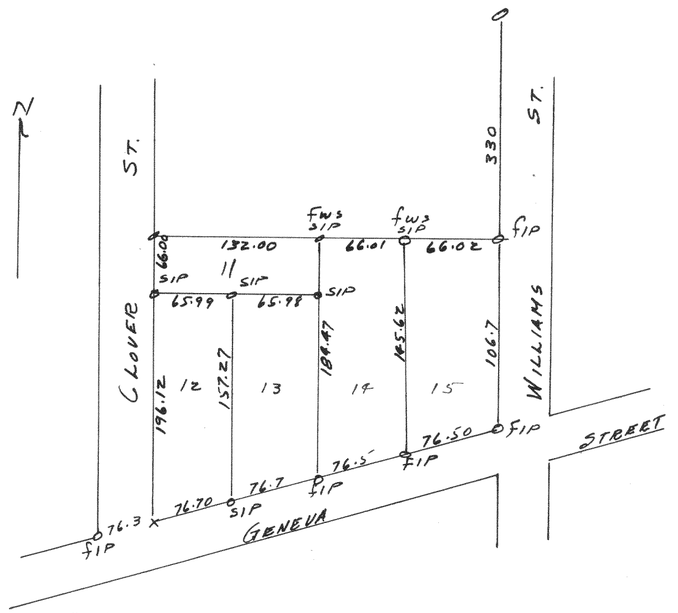

Plat of survey of lot 15 Block 9 of Williams 2nd Addition located in the NE¼ of Sec 1 T1N R16E, Village of Williams Bay Walworth County, Wis.

Sept 30, 1950

Lloyd T. Jensen (CWS)
County Surveyor