

2341

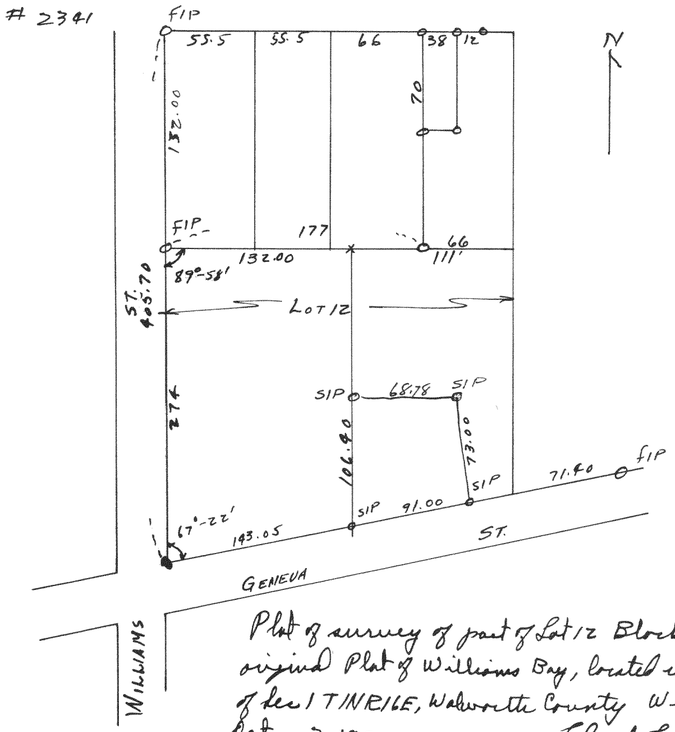

Plat of survey of part of Lot 12 Block 3 of the original Plat of Williams Bay, located in the N.E. ¼ of Sec 1 T1N R16E, Walworth County Wis.
Oct. 3 1950

Lloyd L. Jensen (cwg)
County Surveyor


2342

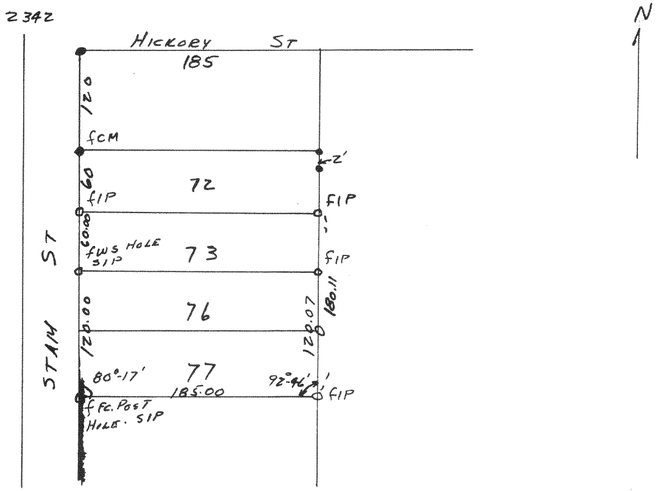

Plat of survey of lots 76 & 77 of Bay View Subd. located in the S.E. ¼ of Sec. 1 T1N R16E Village of Williams Bay, Walworth County Wisc.
Nov 11, 1950

Lloyd L. Jensen (cwg)
County Surveyor


2343

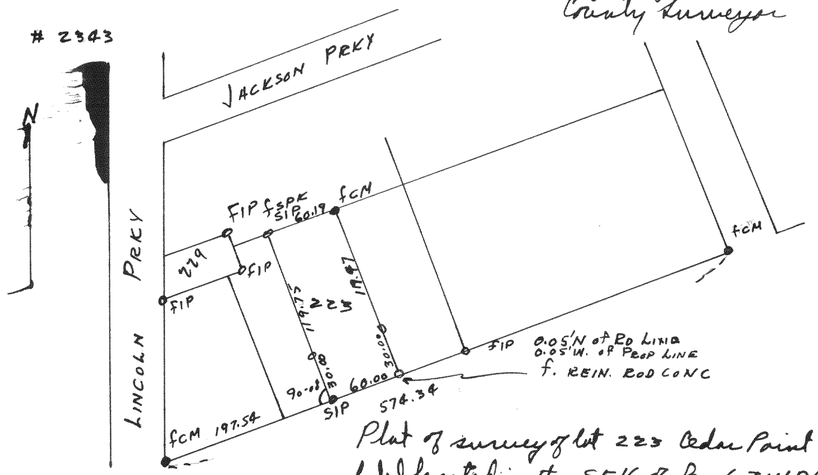

Plat of survey of lot 223 Cedar Point Park Original Subd located in the SE ¼ of Sec 6 T1N R17E, Village of Williams Bay, Walworth County Wisc.
Nov. 6, 1950

Lloyd L. Jensen (cws)
County Surveyor

2344

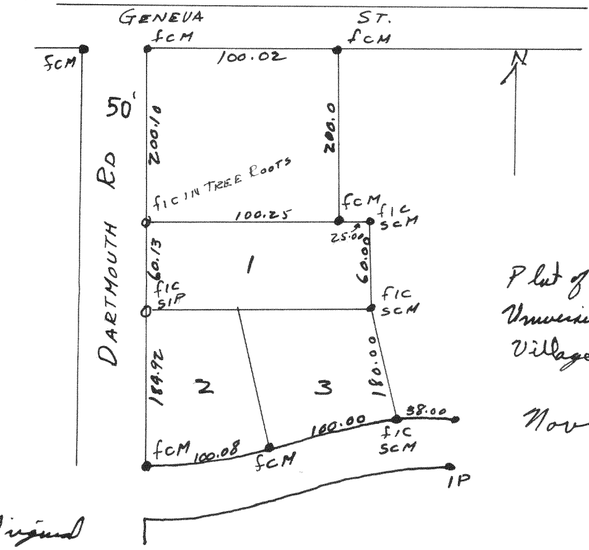

Plat of survey of Lots 1, 2, & 3 & Parcel in Blk 1 of University Heights located in the SE ¼ of Sec 1 T1N R16E Village of Williams Bay, Walworth County, Wis

Nov 13, 1950

Lloyd L. Jensen (cws)
County Surveyor