

2345

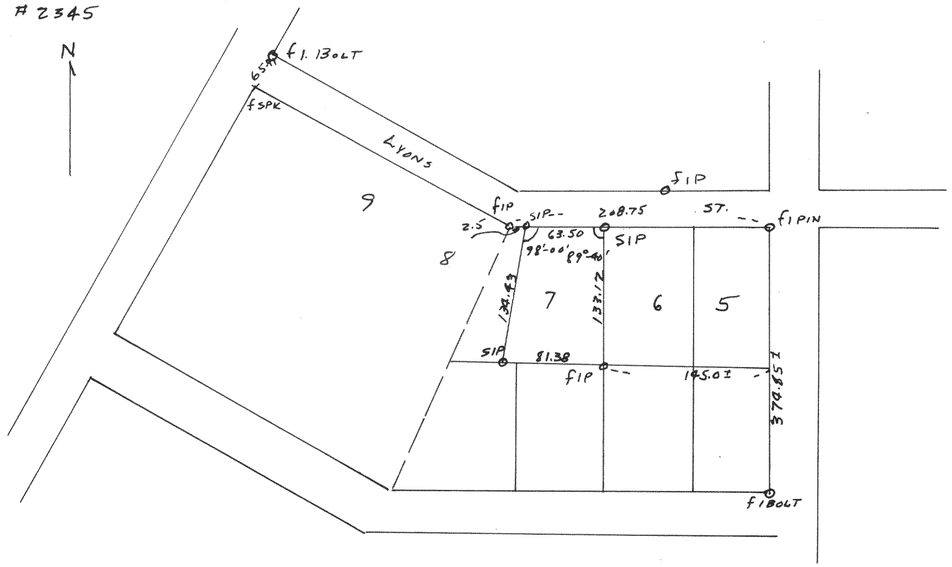

Plat of survey of part of lot 7 of Blk 9 of Nabele Sub'd located in NW¼ of Sec 10 T2N R18E Village of Lyons, Walworth County, Wis.
Dec 4 1950

Lloyd L. Jensen (Surv)
County Surveyor


2346

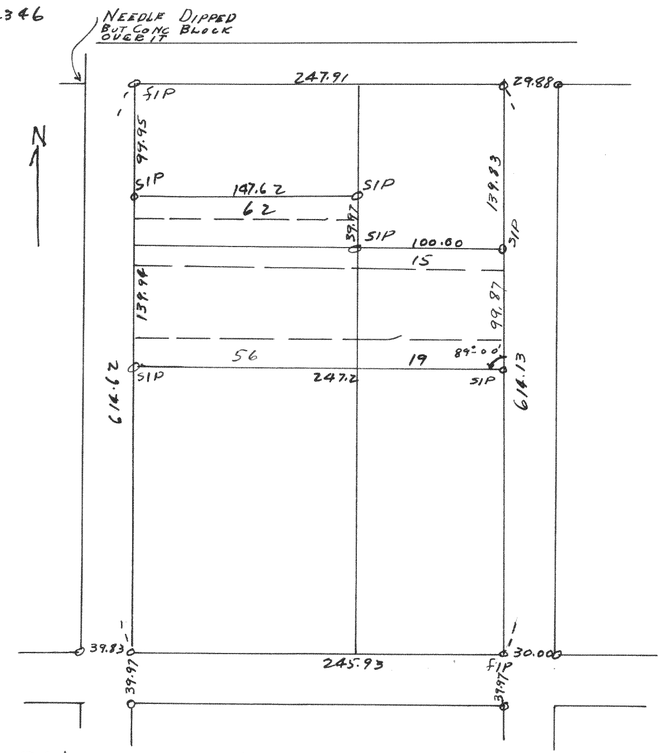

Plat of survey of lots 15-19, 56-62 of Blk 11, Lake Ivanhoe Resort section 2T2NR18E of Walworth County Wis.
Aug 9, 1950

Lloyd L. Jensen (Surv)
County Surveyor

2347

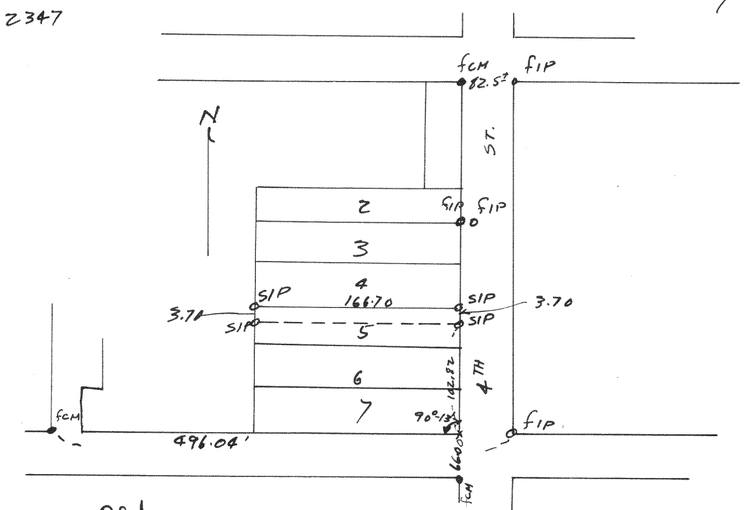

Plat of survey of N line of Lot 5 Blk 2 of S.P. Phoenix Add. located in the City of Delavan, Walworth County, Wis.
Sept 18, 1950

Lloyd L. Jensen (Surv)
County Surveyor