
548


#2348

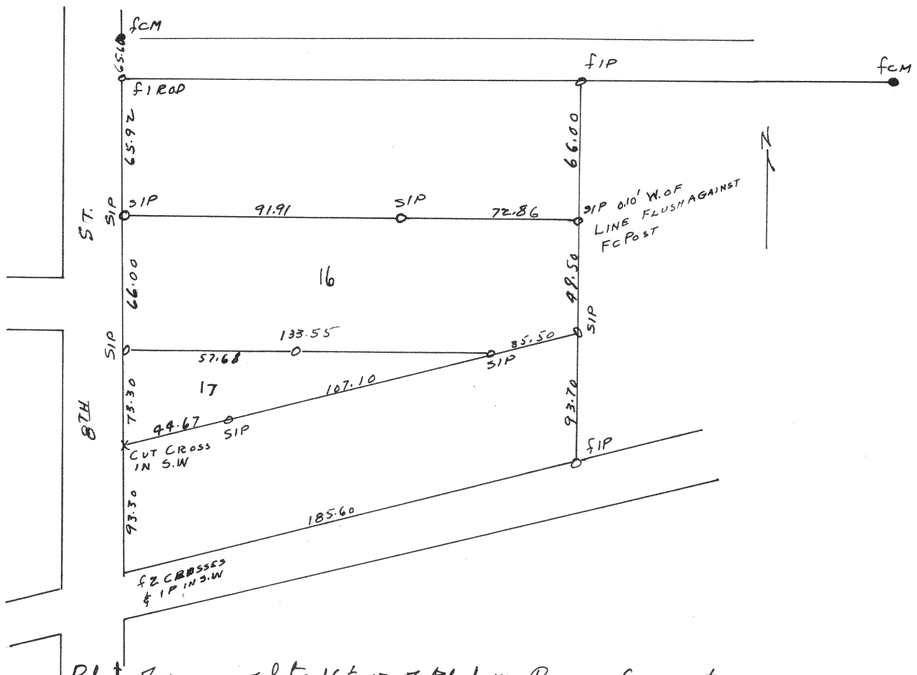

Plat of survey of lots 16 & 17 of Block 17 Passage Aram & Downies Subd located in the City of Delavan, Walworth County, Wis
Sept 19, 1950

Lloyd L. Jensen (cwt)
County Surveyor

2349

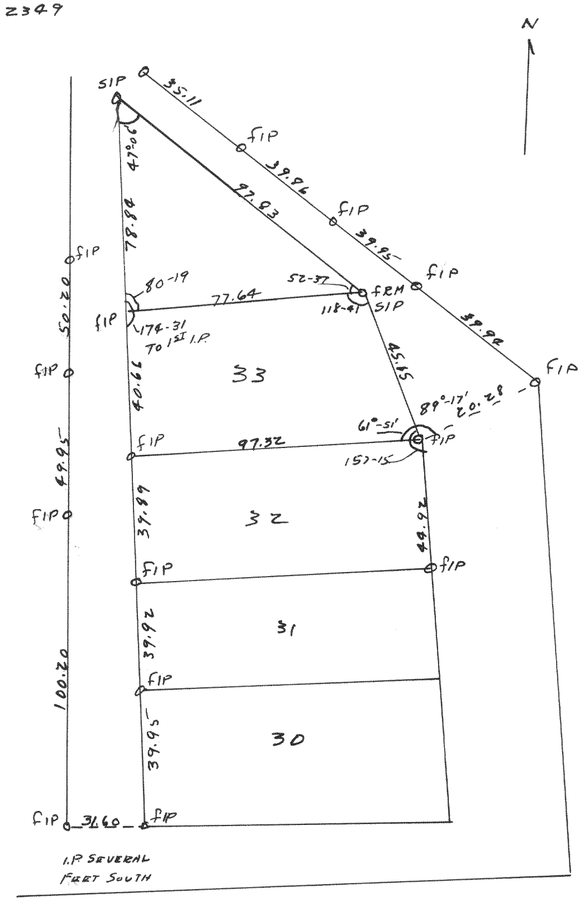

Plat of survey of lot 33 and parcel to the north located in East Nation Park in Sec. 35 T4N R16E of Walworth County, Wis.
1950

Lloyd L. Jensen (cwt)
County Surveyor