
554

#2360 Survey of Grandview Subdivision located in Section 34, T4N R15E of Walworth County, Wisconsin. Plat of Subdivision is on file in the Register of Deeds office in the County Court House, in the City of Elkhorn, Wis.
1950

Lloyd L. Jensen
County Surveyor


#2362

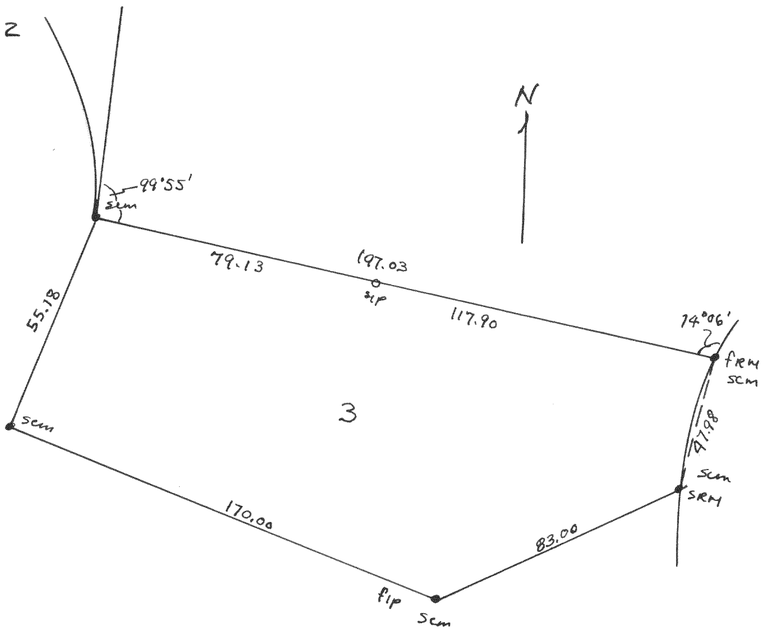

Plat of survey of Lot 3, Block 1 of Wooddale Addition located in Section 9, T1N R15E of Walworth County, Wisconsin.
Aug 1950

Lloyd L. Jensen
County Surveyor

#2361

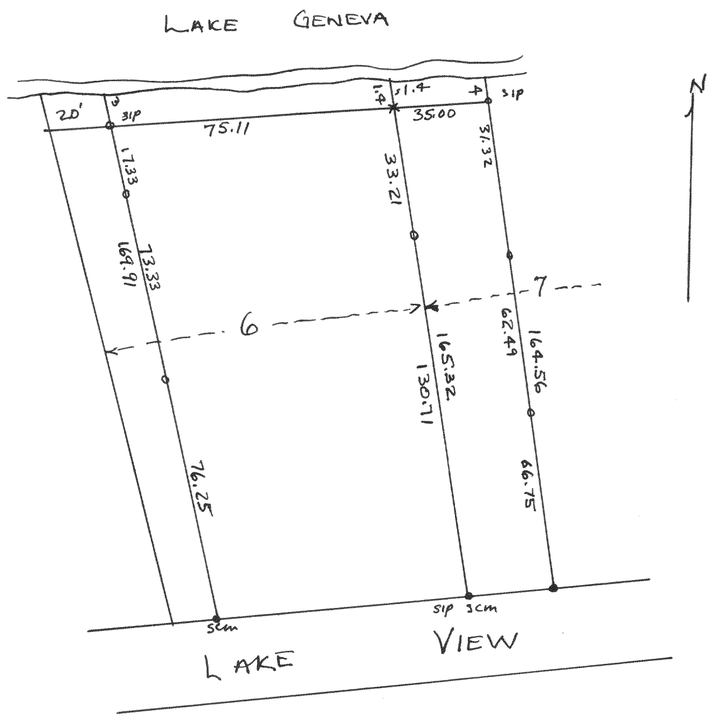

Plat of survey of parts of Lots 6 & 7 of Block 1 of Wooddale Addition located in Section 9, T1N R15E of Walworth County, Wis.
Aug 1950

Lloyd L. Jensen
County Surveyor