
2363

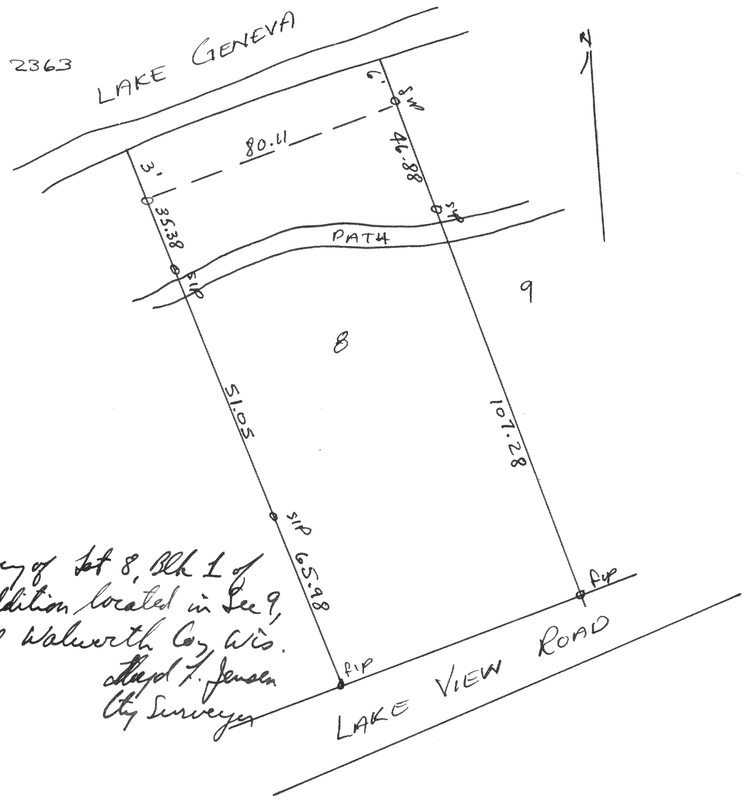

Plat of survey of Lot 8, Blk 1 of Wooddale Addition located in Sec 9, TINCITE of Walworth Co, Wis.
1950


Lloyd L. Jensen
City Surveyor

2364

Plat of survey of Lot 4, Block 1 of Wooddale Addition located in Sec 9, TINCITE, Walworth County, Wis.
Aug 1950

Lloyd L. Jensen
County Surveyor

#2365

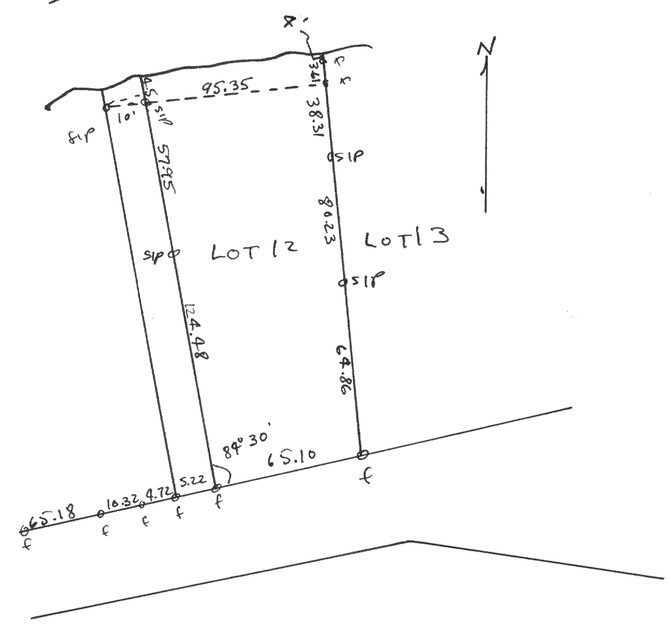

Plat of survey of part of Lot 12, Block 1 of Wooddale Addition located in Sec 9, TINCITE, of Walworth County, Wis.
Aug 1950

Lloyd L. Jensen
County Surveyor