

2370

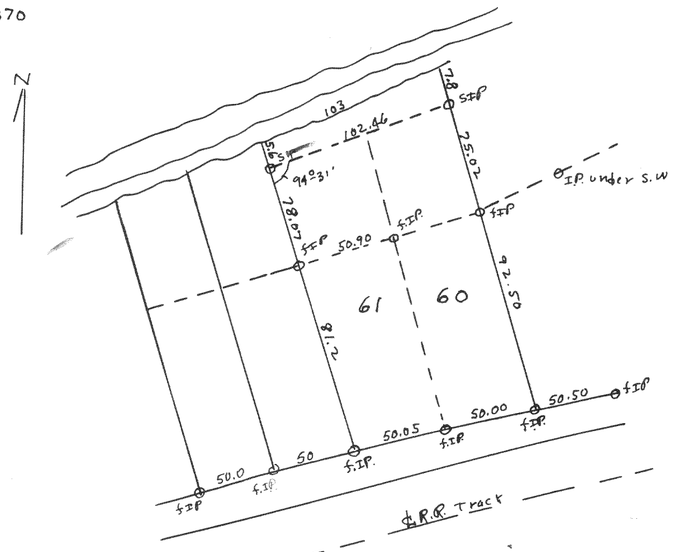


Plat of survey of lots 60&61 of Consumers Company Subd. located in Section 32 T 2N R17E of Walworth county, Wisc
Oct 9, 1950
Lloyd L Jensen
County Surveyor

2371

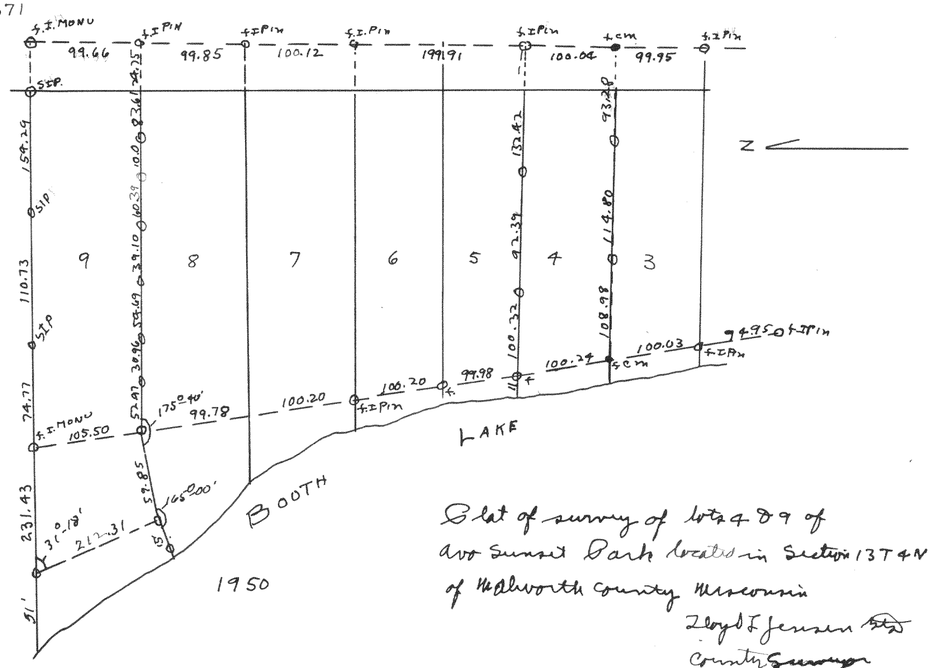


Plat of survey of lots 4 & 9 of Avo Sunset Park located in Section 13 T 4N R17E of Walworth County Wisconsin
Lloyd L Jensen
County Surveyor

2372

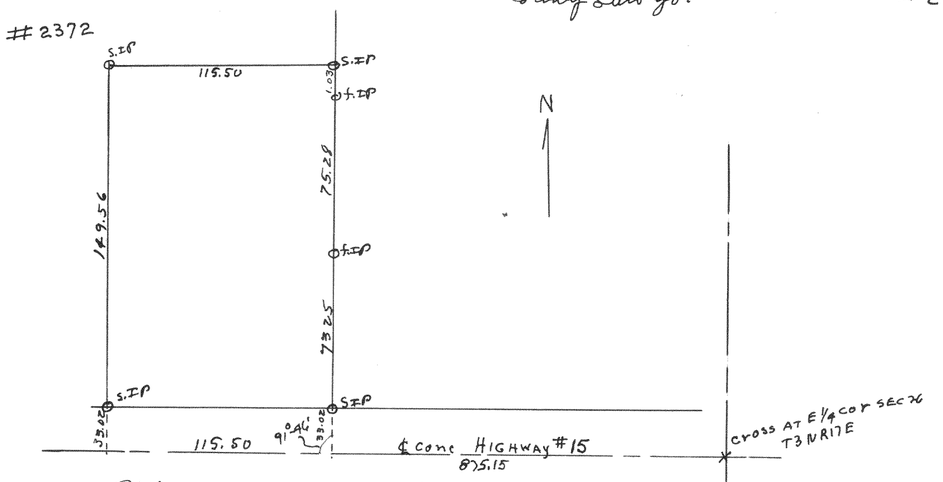

Plat of survey of a parcel of land located in the NE¼ of Sec 26 T3N R17E of Walworth County, Wis.
June 16, 1950
Lloyd L Jensen
County Surveyor
Cert.

2373

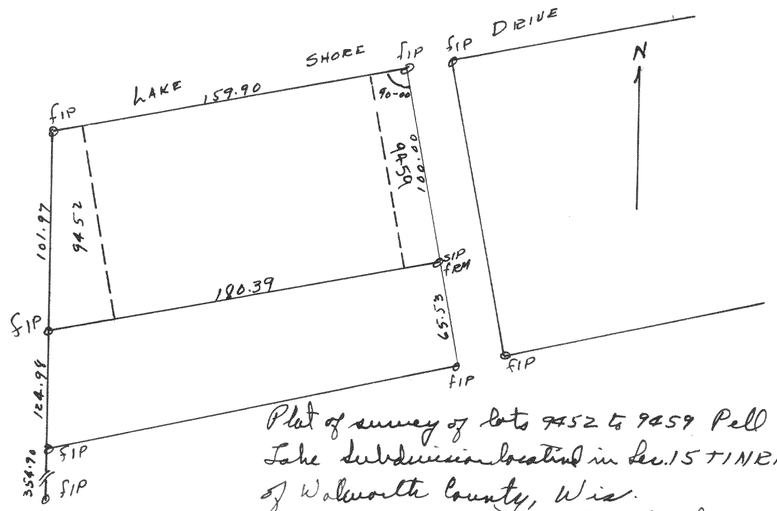

Plat of survey of lots #452 to #459 Pell Lake Subdivision located in Sec. 15 T1N R18E of Walworth County, Wis.
Lloyd L Jensen
County Surveyor.
Cert.