
562


2382

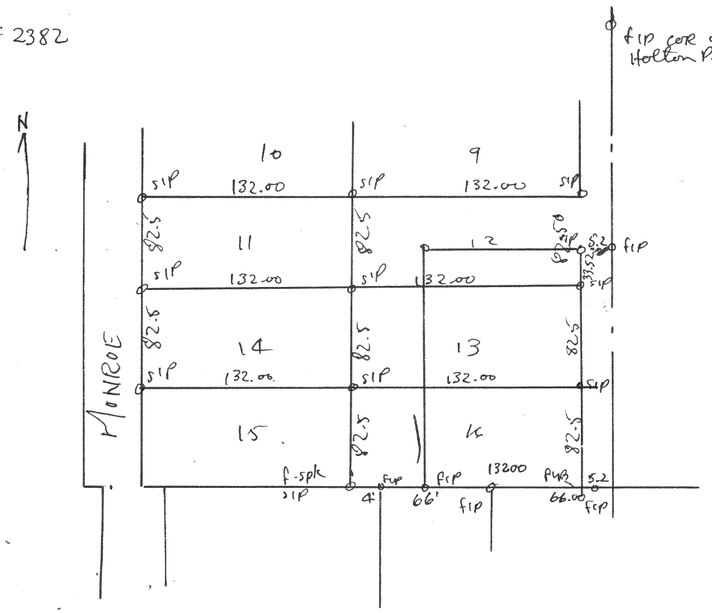

Plat of survey of Lots 11-14, 16 of Block 1 of Harrisons Add. located in the City of Elkhorn in Walworth County, Wis.
Nov. 1950

Loyd A Johnson
County Surveyor

2383

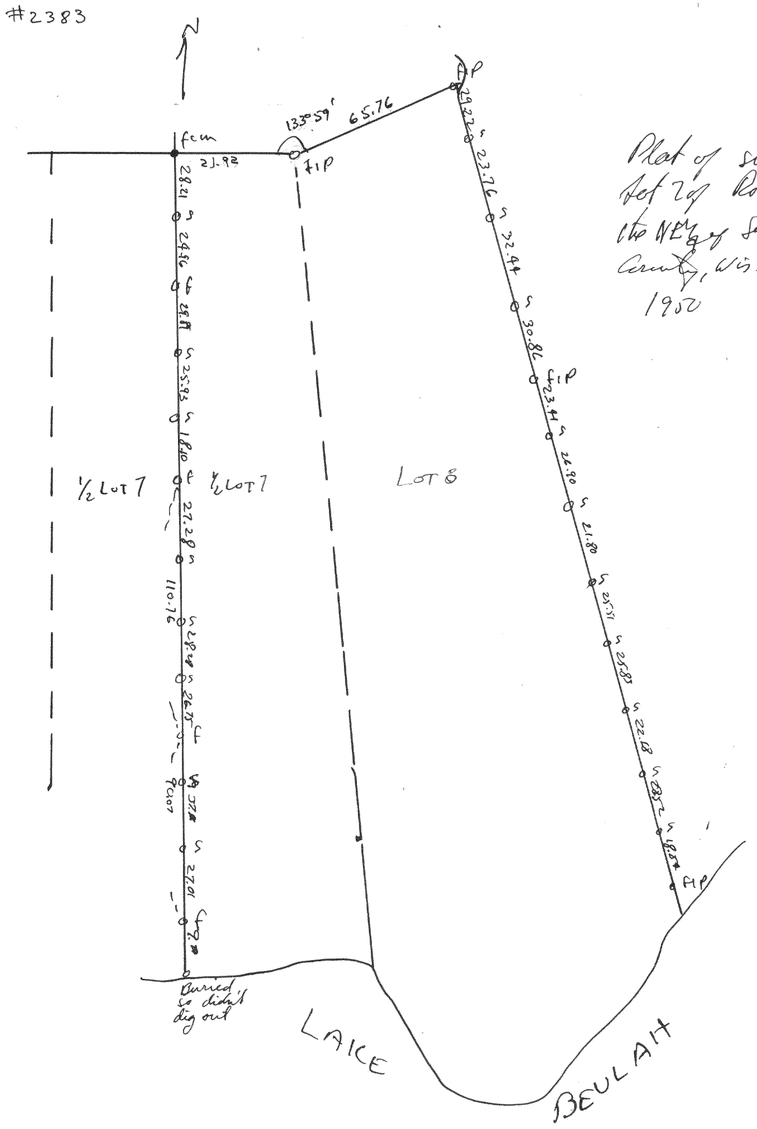

Plat of survey of Lot 8 & part of Lot 7 of Ronalea Park located in the NE¼ of Sec 8, T4N R15E of Walworth County, Wis.
1952

Loyd A Johnson
County Surveyor