
566

2391

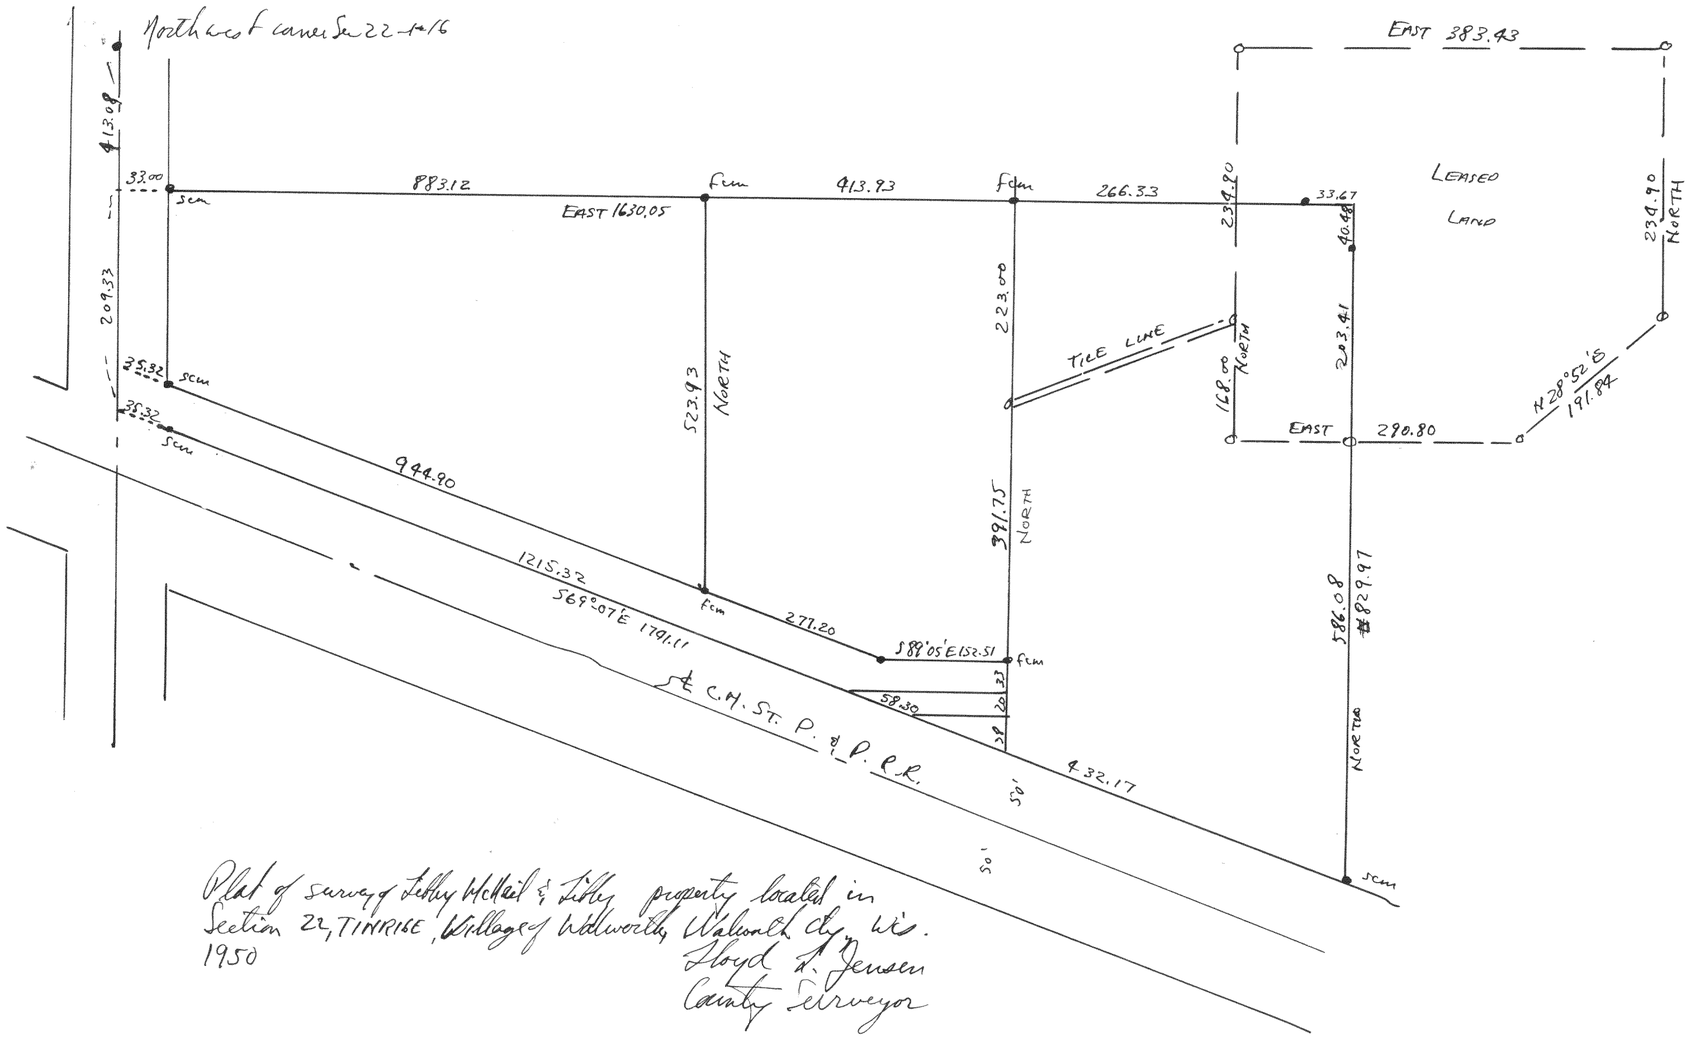

Plat of survey of Libby McNeil & Libby property located in Section 22, T1N R15E, Village of Walworth, Walworth Cty, Wis.
1950

Lloyd A. Jensen
County Surveyor