

#2392

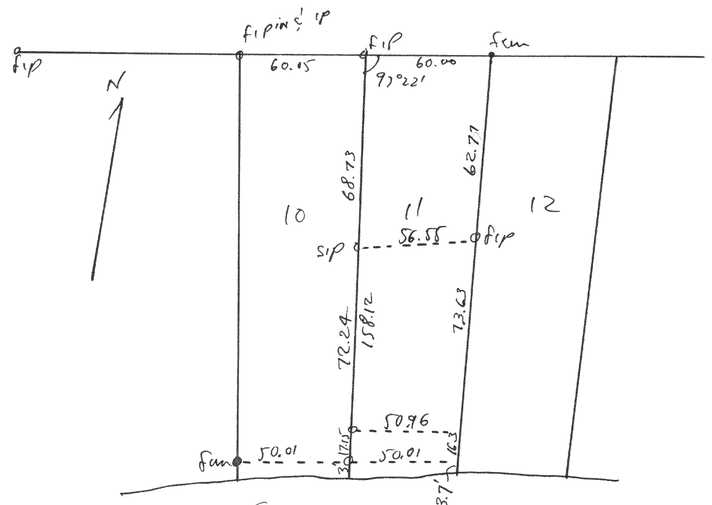

Plat of survey of Lot 11, Blk A, Cisco Beach Subd., located in the NE¼ of Sec 8, T1N R17E of Walworth City, Wis-
Nov 1950

Lloyd J. Jensen
County Surveyor

#2394

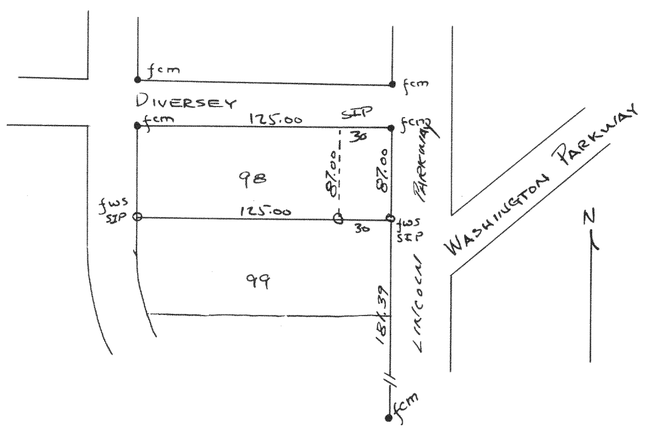

Plat of survey of Lot 98 original plat Cedar Point Park Village of Williams Bay, Walworth County, Wisconsin
Oct. 24, 1951

Lloyd J. Jensen
County Surveyor
QEB

Back to here
3-26-51
LJJ

567


#2393



Plat of survey of lots 112-113 Cedar Point Park 2nd Add. Village of Williams Bay, Walworth County, Wisc.
Oct 23, 1951

Lloyd J Jensen QEB
County Surveyor

2395

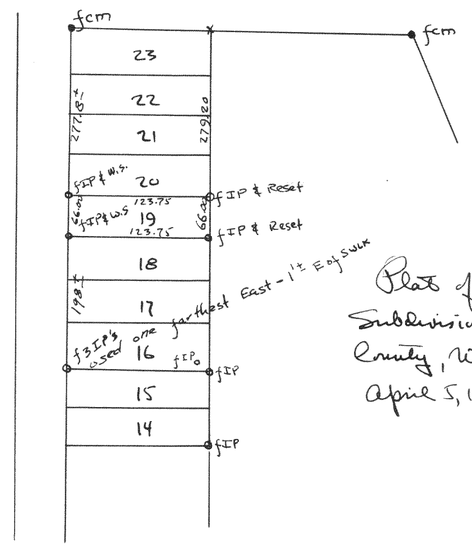

Plat of survey of lot 19 Parkland Subdivision, City of Whitewater, Walworth County, Wisconsin
April 5, 1951

Lloyd L Jensen
County Surveyor
QEB