

#2398

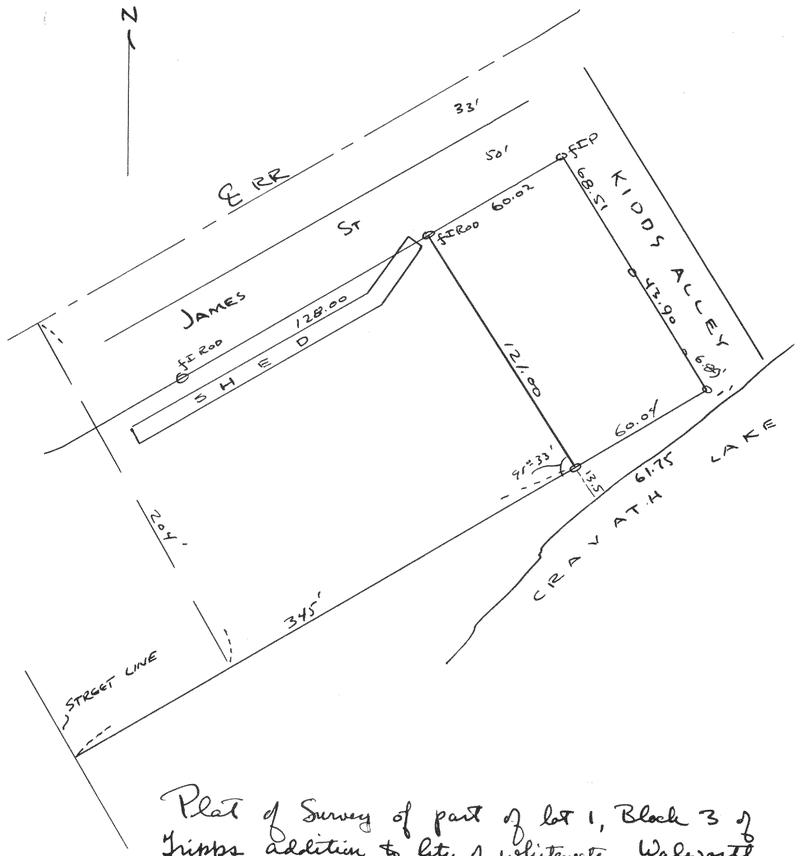

Plat of Survey of part of lot 1, Block 3 of Tripps addition to City of Whitewater, Walworth County, Wisconsin
May 24, 1951

Lloyd L. Jensen jcs
County Surveyor

#2399

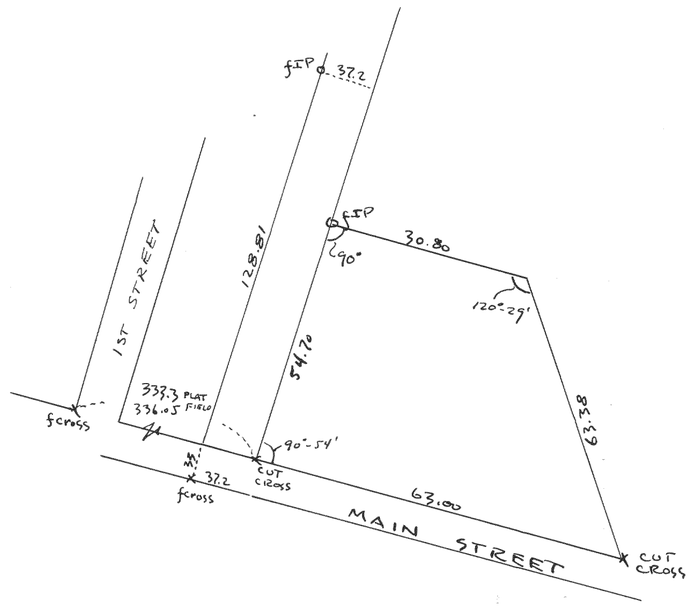

Plat of Survey of the Pure Oil Station located just east of Blk 1, Original Town SW 1/4, Section 4, T4N R15E, City of Whitewater, Walworth County, Wisconsin
May 25, 1951

Lloyd L. Jensen jcs
County Surveyor