

SURVEY NO. 1287

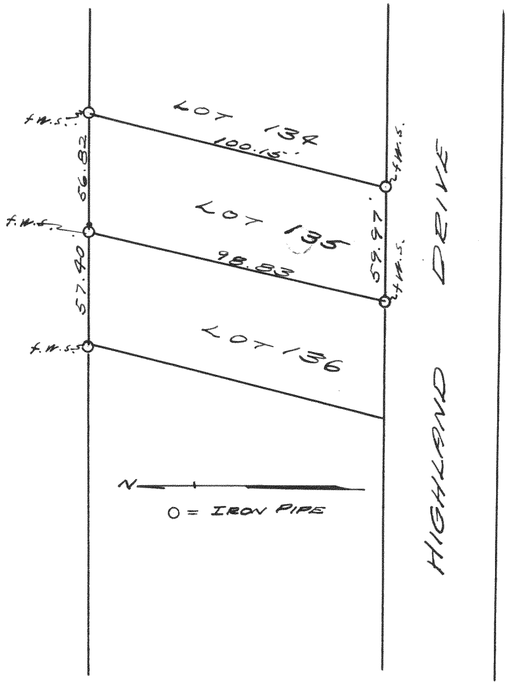

PLAT OF SURVEY OF LOT 135 OF THE 2ND ADDITION TO CEDAR POINT PARK IN THE VILLAGE OF WIND. BAY, WALWORTH COUNTY, WISC.
AUG. 29, 1941

Lloyd L. Jensen
W.E.J.

SURVEY NO. 1288

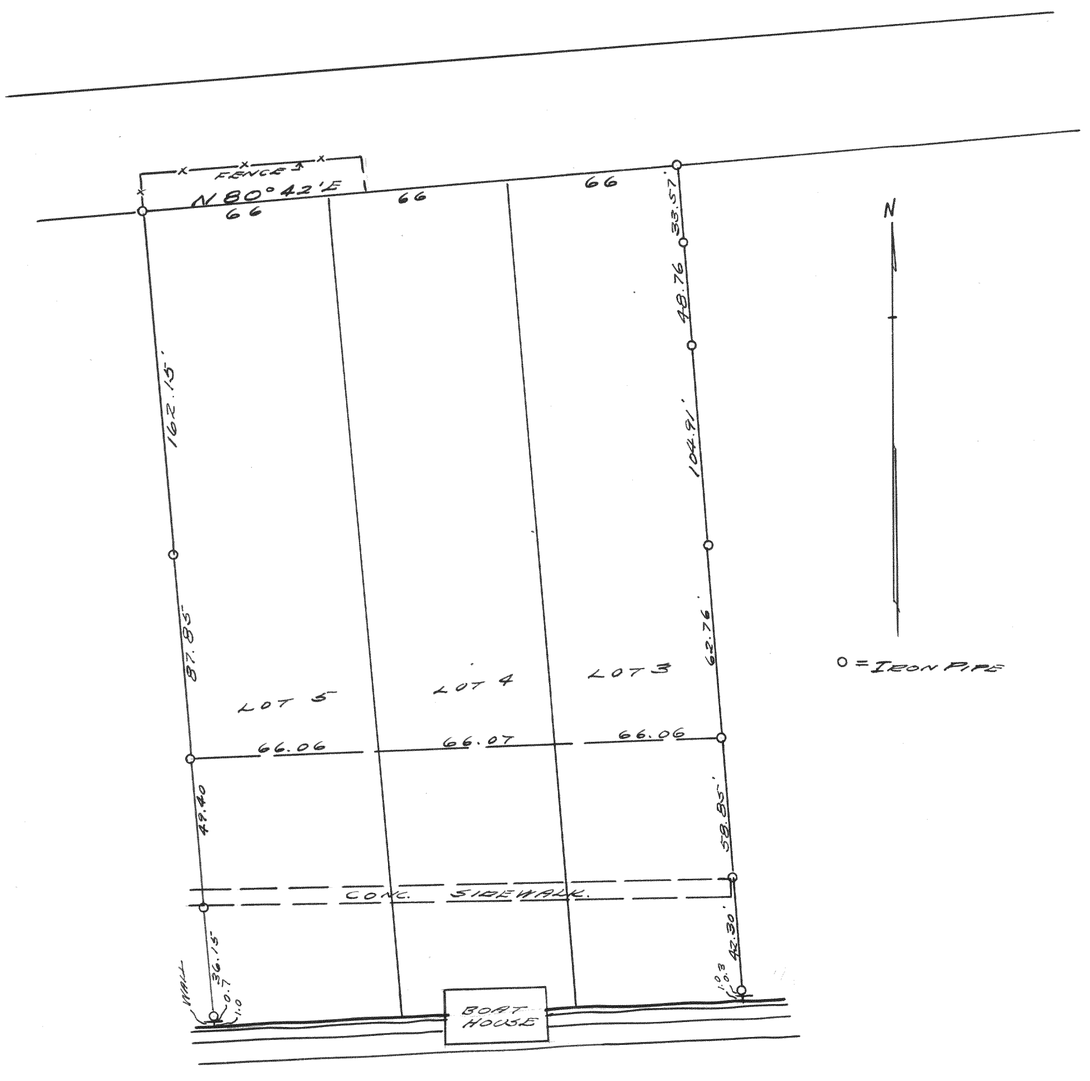

PLAT OF SURVEY OF LOTS 3, 4 & 5 OF ST. MARY'S SUBD. IN THE NW¼ SECTION 28 T3N R16E, WALWORTH COUNTY, WISCONSIN.
FEB., 1942

Lloyd L. Jensen
W.E.J.