
570

#2400

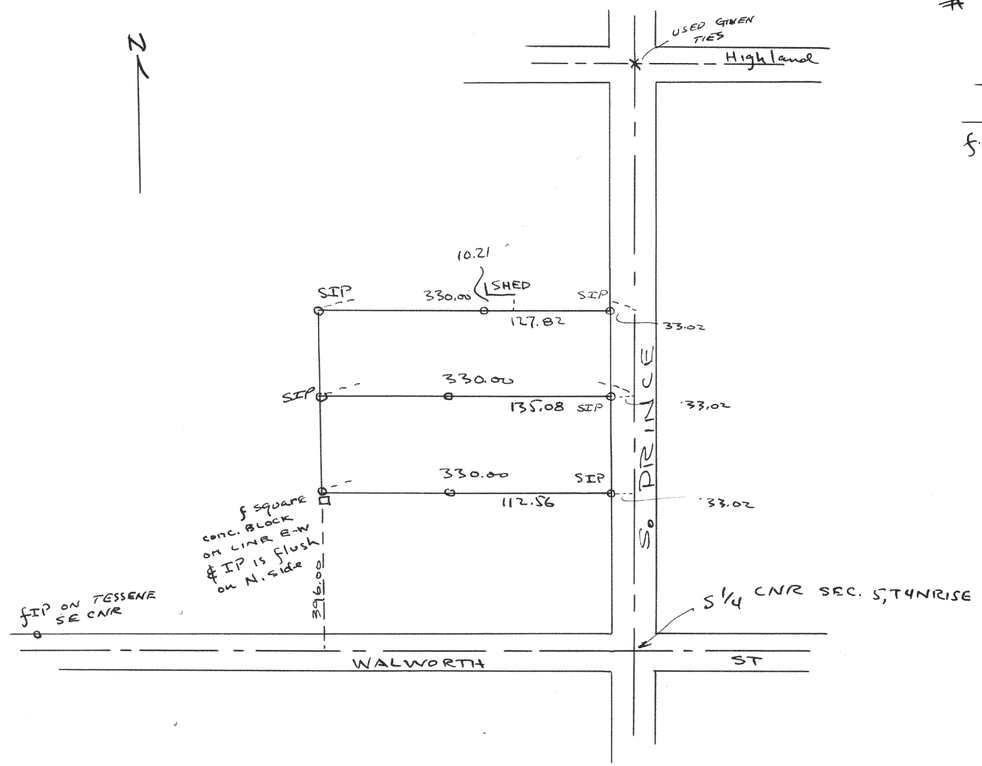



Plat of survey of land for Rutoski in the SW 1/4 of Section 5, T4N R15E, City of Whitewater, Walworth County, Wisconsin

1951

Lloyd L. Jensen JCB
County Surveyor

#2401

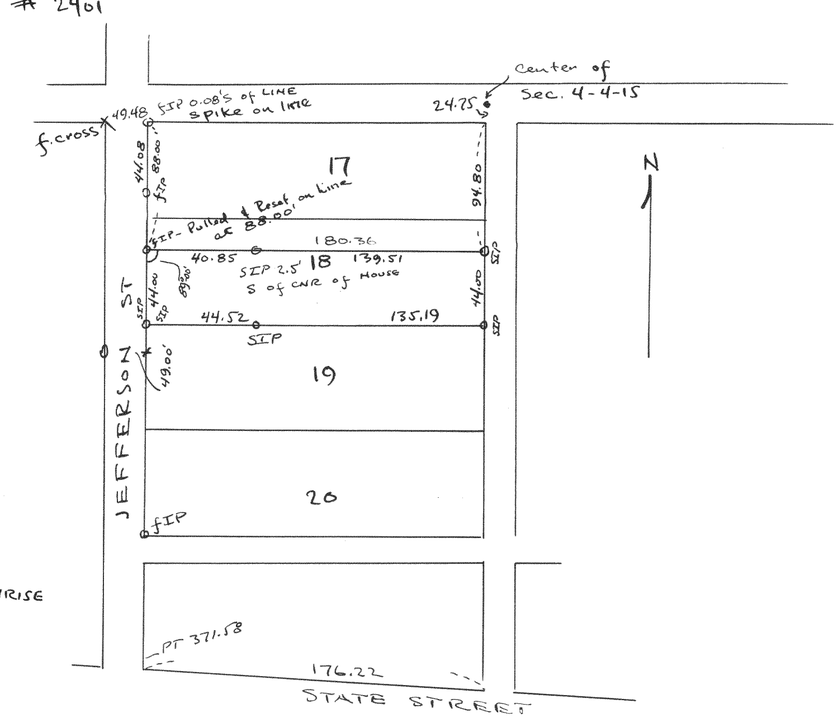



Plat of survey of the S 44 ft. of lot 18, Blk 1 Tripps 2nd Add., City of Whitewater, Wis.

Aug. 7, 1951

Lloyd L. Jensen JCB
County Surveyor

#2402

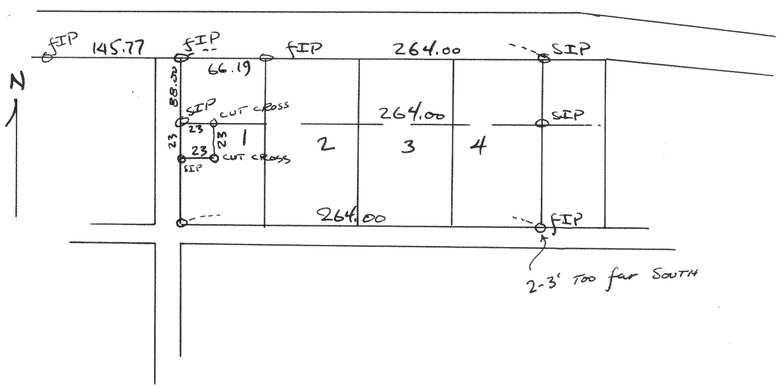


Plat of survey of part of lots 1-4 Blk. 8 of S.C. Wells Addition - City of Whitewater Walworth County, Wisconsin

Dec. 12, 1951

Lloyd L. Jensen JCB
County Surveyor